




3 OPEN SIDED BLDG.  
1/8" = 1'-0"

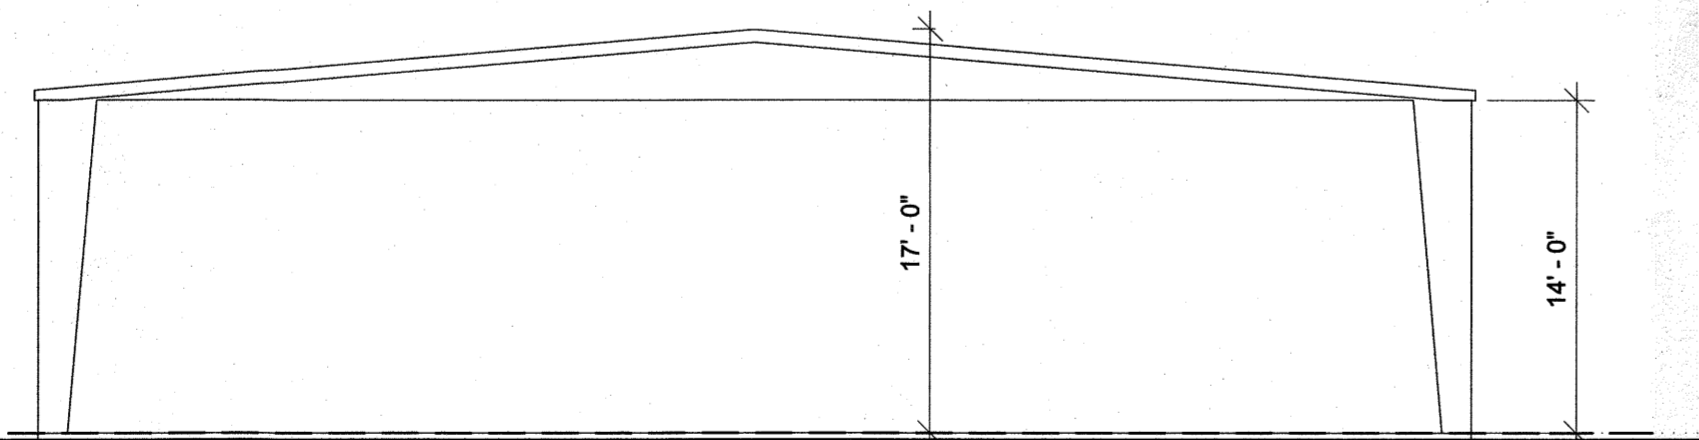

4 OPEN SIDED BLDG RIGHT SIDE ELEV.  
1/8" = 1'-0"

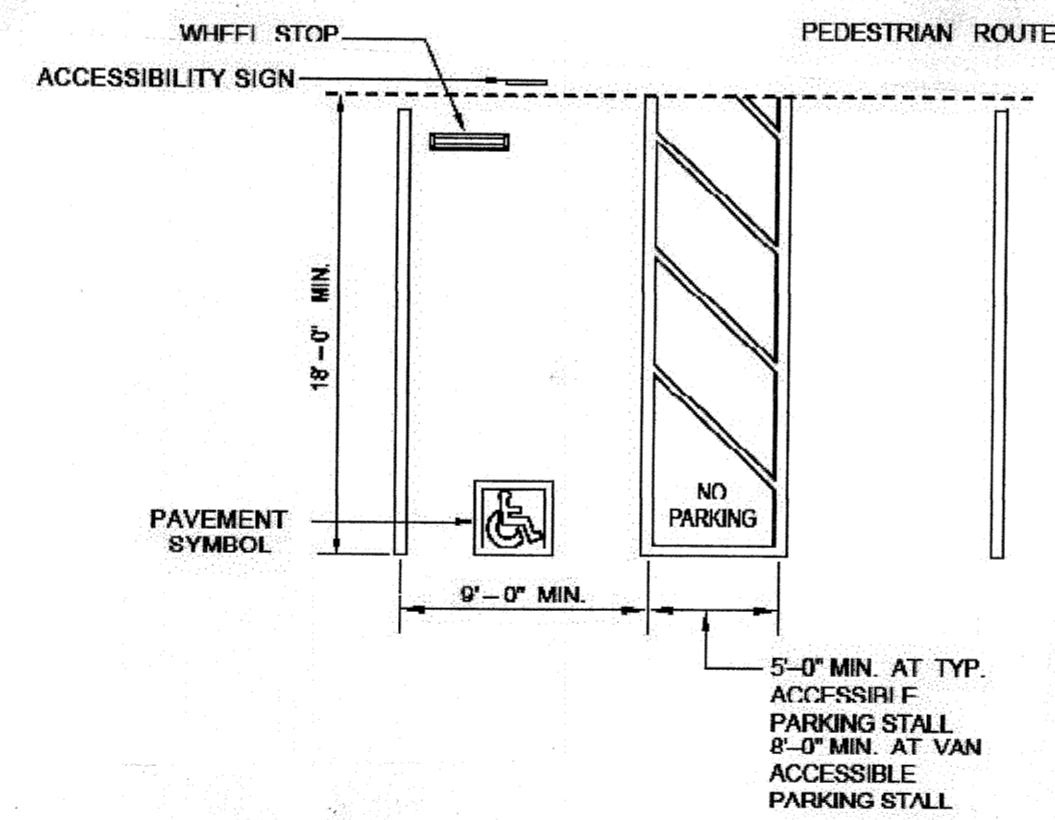

ADA VAN ACCESSIBLE

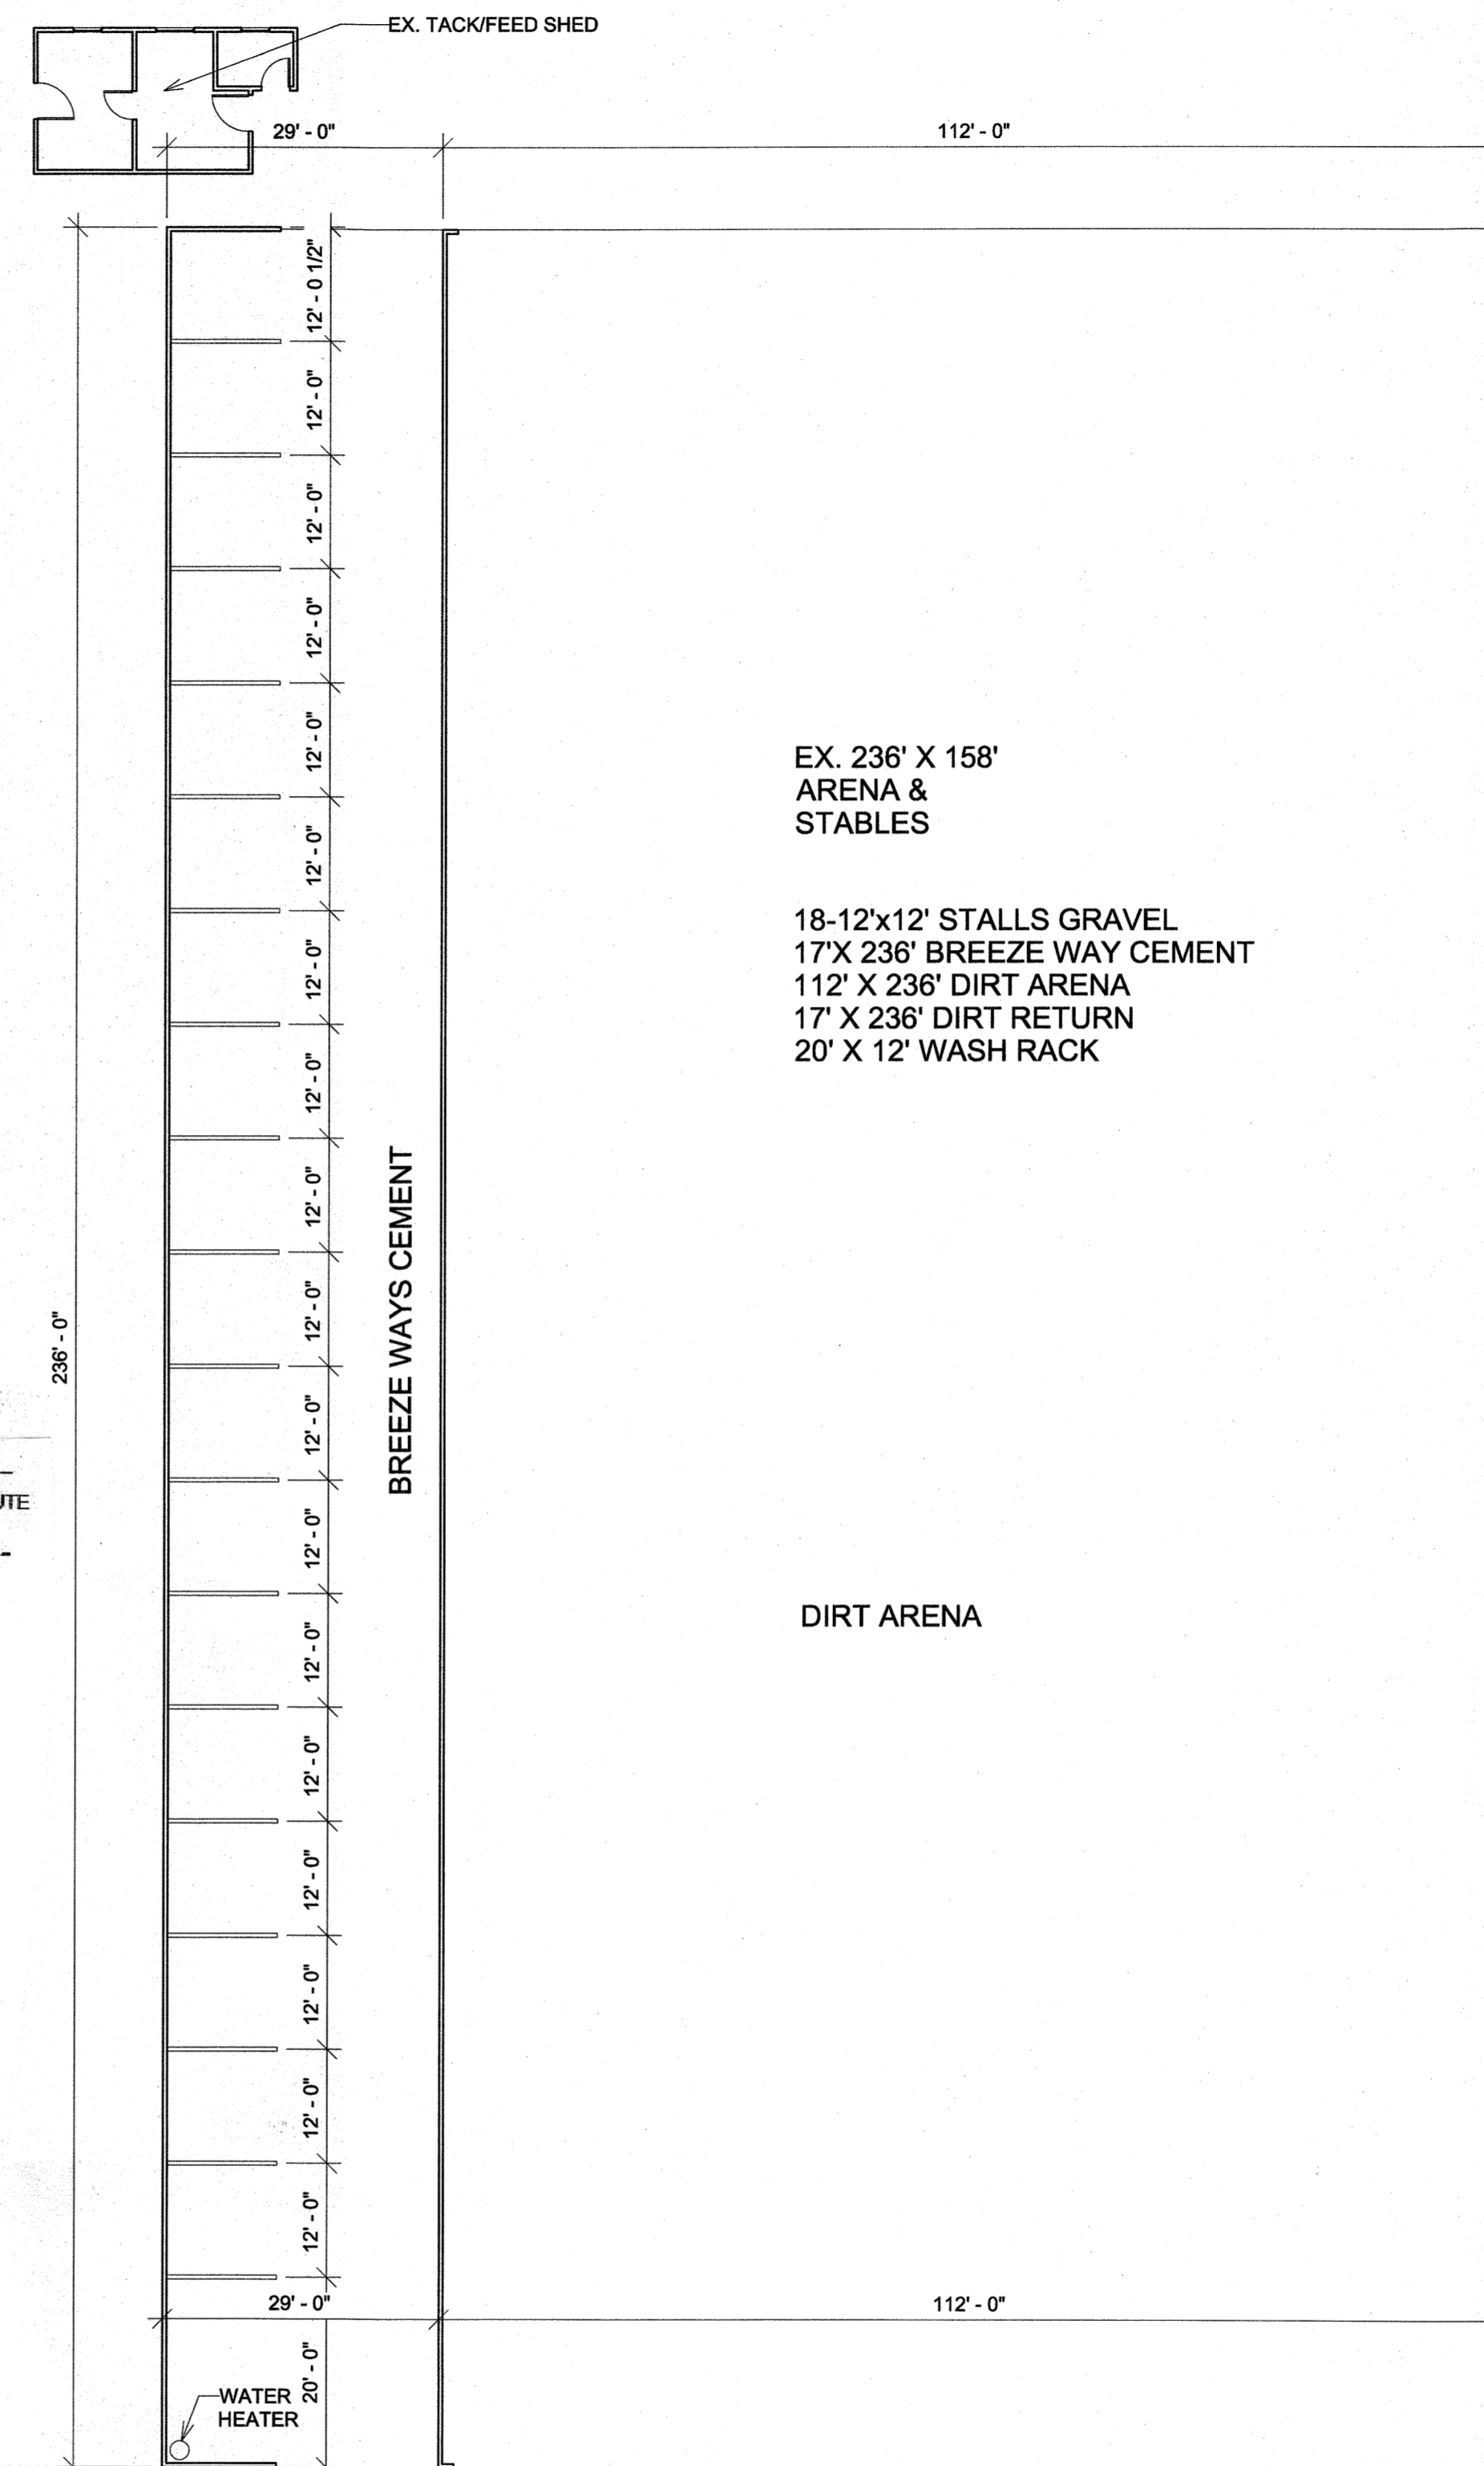


1 ARENA & STABLES PLAN  
1/16" = 1'-0"

REVISIONS	BY


TOM LINN DRAFTING & DESIGN  
P.O. BOX 313  
ANTIOCH, CA  
925-756-7848  
tomlinndrafting@sbcglobal.net

2235 SUNSET RD. BRENTWOOD CA  
RECORD DRAWING

DRAWN RA
CHECKED TL
DATE 20.04.27
SCALE AS SHOWN
JOB NO. 
SHEET A102

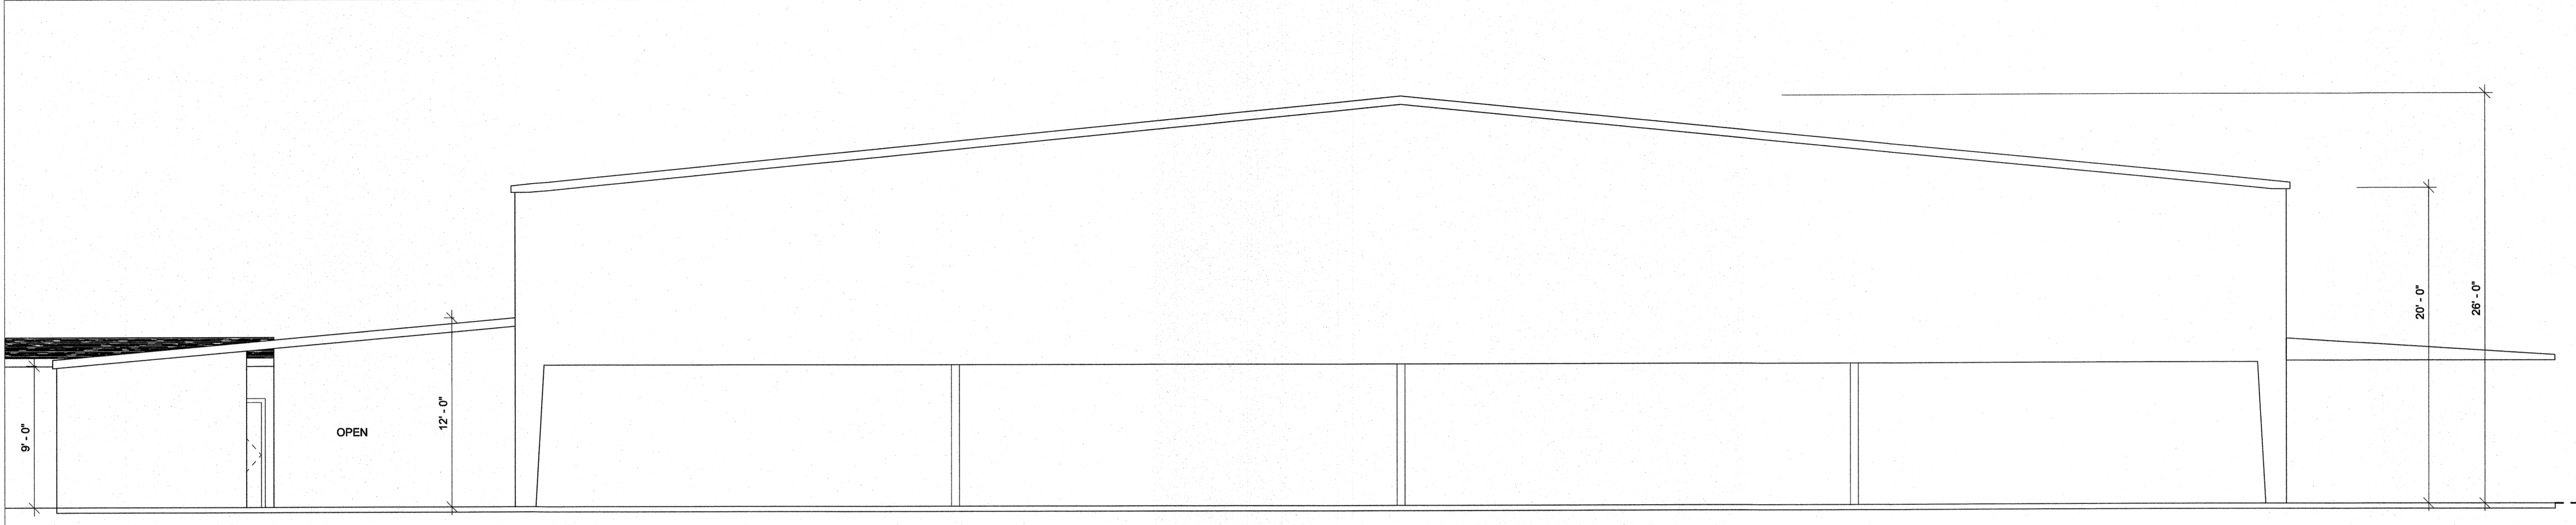

① ARENA & STABLES FRONT ELEV.  
3/16" = 1'-0"

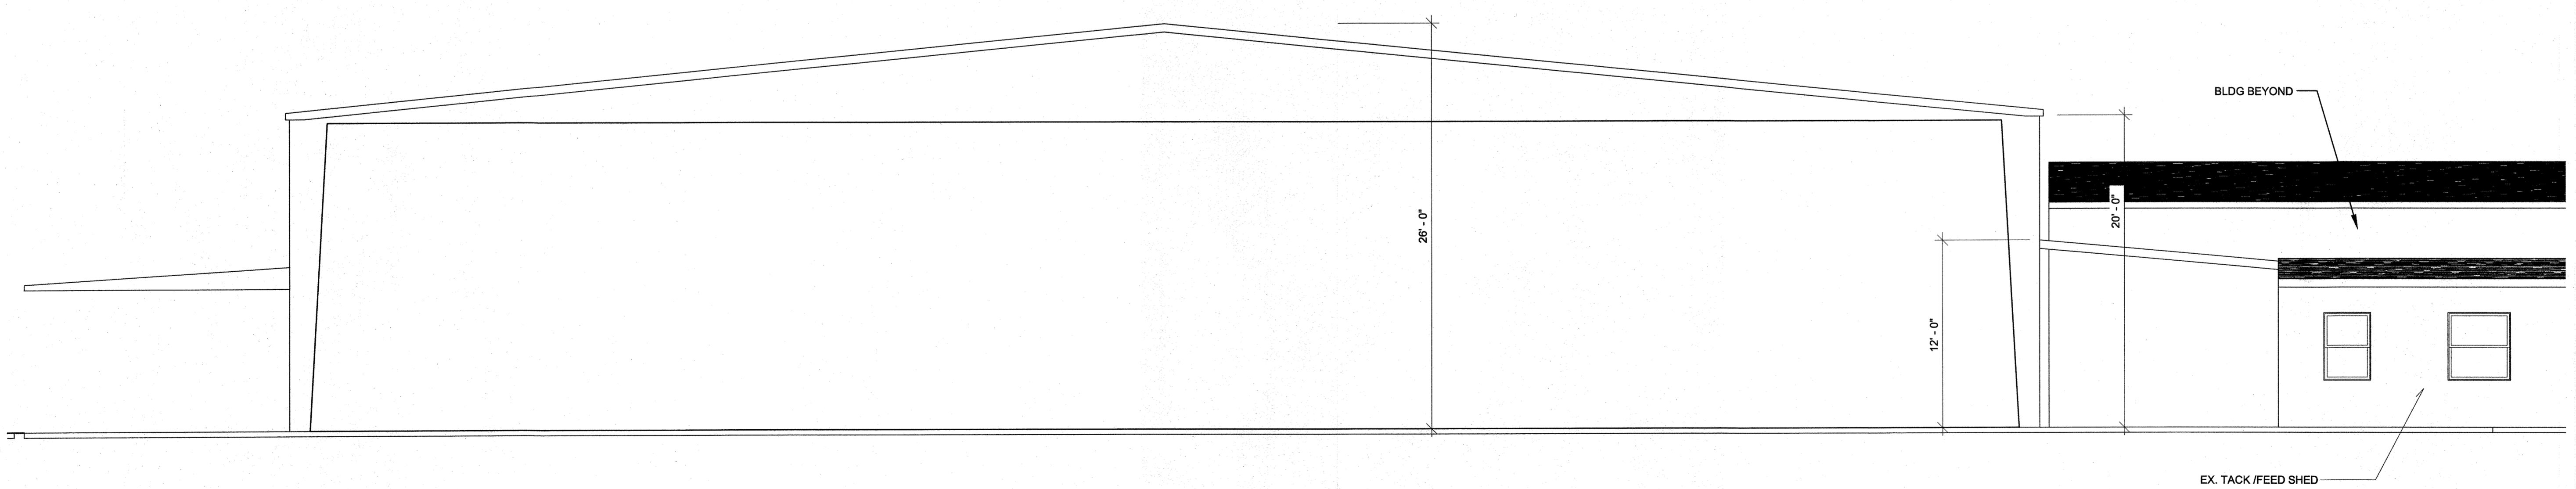

② ARENA & STABLES REAR ELEV.  
3/16" = 1'-0"

REVISIONS	BY

**TOM LINN DRAFTING & DESIGN**  
 P.O. BOX 313  
 ANTIOCH, CA  
 925-756-7848  
 tomlindrafting@sbcglobal.net

**2235 SUNSET RD. BRENTWOOD CA**  
**RECORD DRAWING**

DRAWN RA
CHECKED TL
DATE 20.04.27
SCALE AS SHOWN
JOB NO.
SHEET <b>A103</b>