



RECEIVED on 10/08/2025 CDR225-03279
By Contra Costa County
Department of Conservation and Development

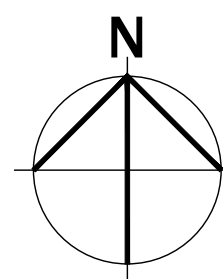


NOTE:
THIS IS NOT A LAND SURVEY, PROPERTY LINE LOCATIONS ARE NOT DETERMINED.
PROPERTY LINE PLACEMENT BASED ON EXISTING STRUCTURES AND CONTRA COSTA COUNTY GIS TAX MAP INFORMATION. ASBUILT SERVICES ASSUMES NO LIABILITY FOR MISUSE OF PROPERTY LINE INFORMATION.

1 EXISTING ARCHITECTURAL SITE PLAN

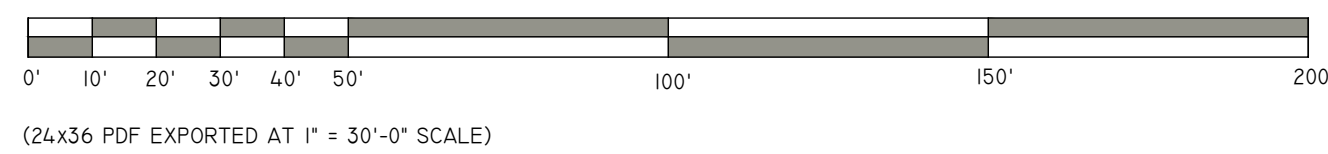

4677 PACHECO BOULEVARD
MARTINEZ, CA. 94553

THIS DRAWING IS A RECORD OF REAL PROPERTY THAT IS GENERALLY ACCEPTED TO BE SUITABLE FOR USE IN PLANNING, DESIGN, LEASE, AND GENERAL ASSET MANAGEMENT. IT SHOULD NOT BE USED TO DETERMINE EXACT MEASUREMENTS OF SPACES OR ARTIFACTS FOUND HEREIN FOR ANY PURPOSE.
EXTERIOR ELEMENTS HAVE BEEN MEASURED AND DRAFTED FOR REFERENCE ONLY - THIS IS NOT A SURVEY.

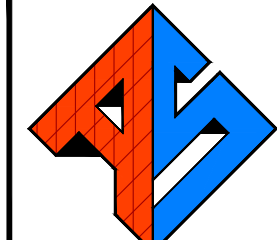

**ASBUILT
SERVICES**
FOR THE RECORD SINCE 1990
1-800-318-0099 ASBUILTSERVICES.COM

EXISTING SITE PLAN

REF: 4677SF_East_RTL
REV: 0
DRAWN BY: DS
AUDITED BY: TL

SHEET SIZE: 24x36
SCALE: 1" = 30'-0"
FIELD MEASURE:
09/03/2025

AX-100
1 OF 5



4677 PACHECO BOULEVARD
MARTINEZ, CA. 94553




ASBUILT
SERVICES

FOR THE RECORD SINCE 1990

1-800-318-0099 ASBUILTSERVICES.COM

EXISTING ROOF PLAN

AX-101

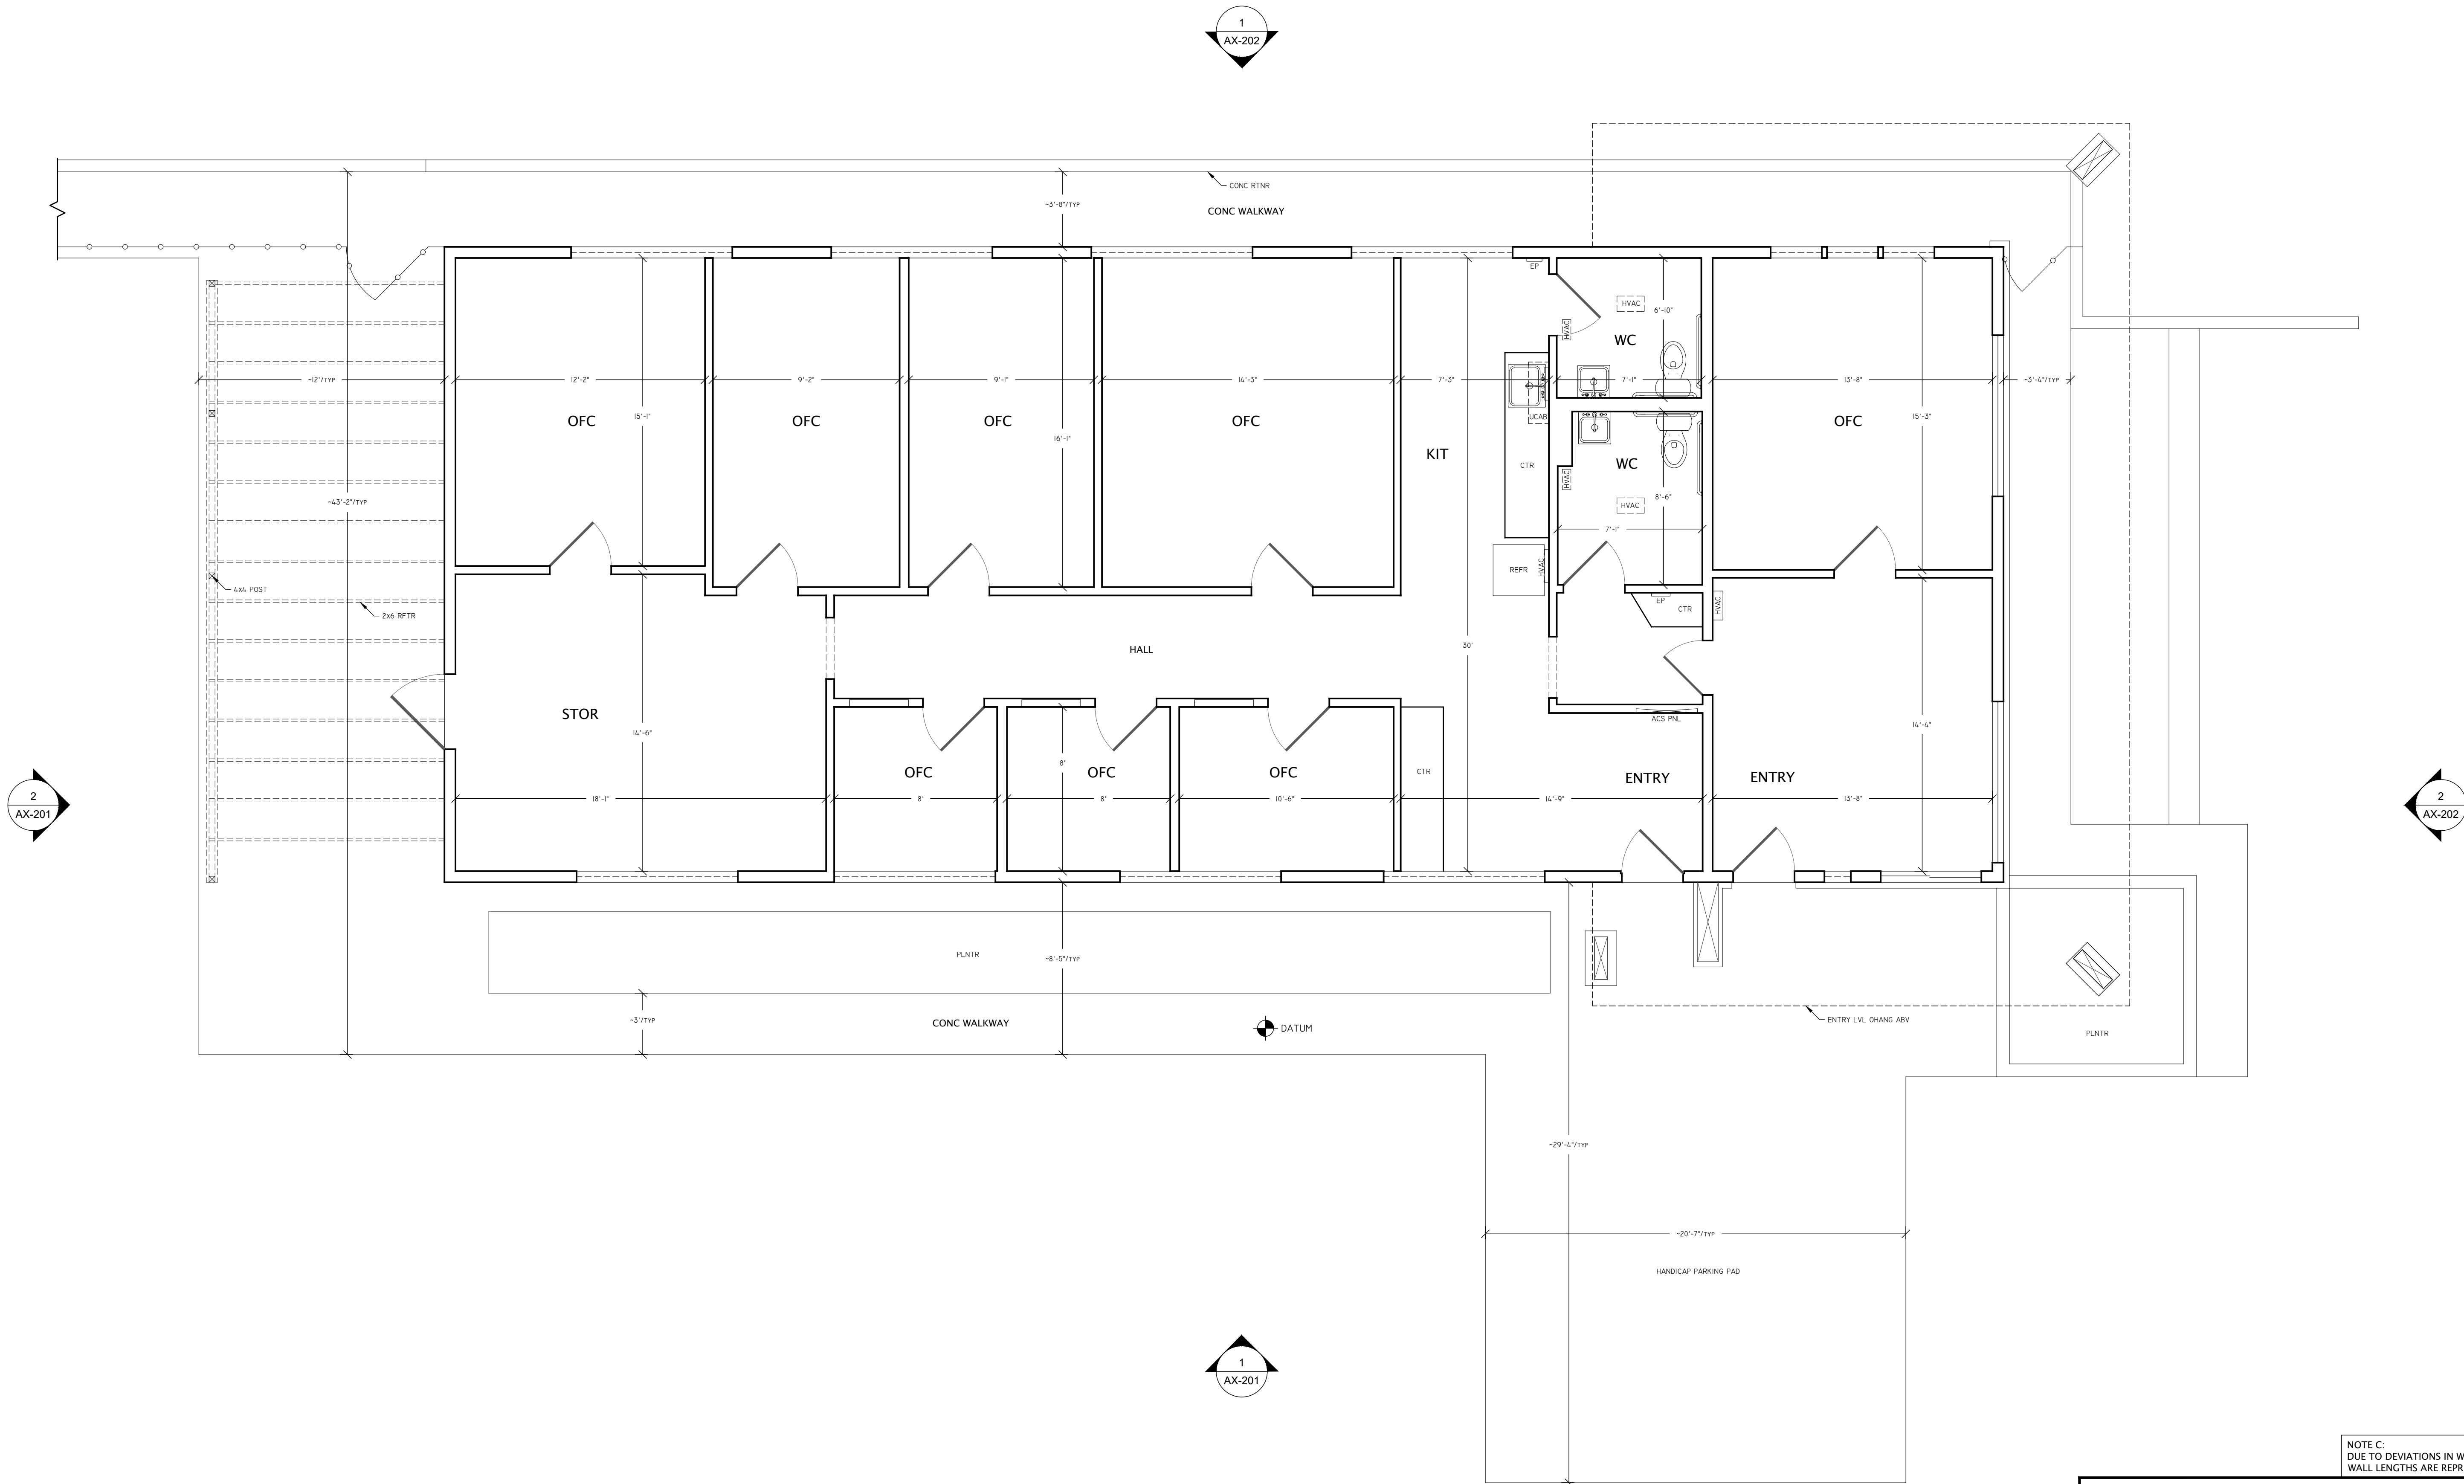


1 EXISTING ENTRY LEVEL FLOOR PLAN
2,368 SQFT CROSS MEASURED AREA
589 SQFT MEASURED EXTERIOR SURFACES

NOTE C:
DUE TO DEVIATIONS IN WALL ANGLES AND SURFACES, SOME
WALL LENGTHS ARE REPRESENTED AS TYPICAL.

4677 PACHECO BOULEVARD
MARTINEZ, CA. 94553

THIS DRAWING IS A RECORD OF REAL PROPERTY
THAT IS GENERALLY ACCEPTED TO BE SUITABLE
FOR USE IN PLANNING, DESIGN, LEASE, AND
GENERAL ASSET MANAGEMENT. IT SHOULD NOT BE
USED TO DETERMINE EXACT MEASUREMENTS OF
SPACES OR ARTIFACTS FOUND HEREIN FOR ANY
PURPOSE.

EXTERIOR ELEMENTS HAVE BEEN MEASURED AND
DRAFTED FOR REFERENCE ONLY - THIS IS NOT A
SURVEY.

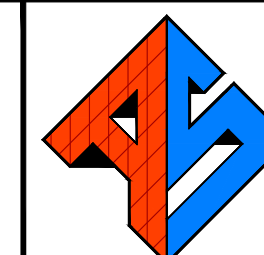



**ASBUILT
SERVICES**
FOR THE RECORD SINCE 1990
1-800-318-0099 ASBUILTSERVICES.COM

EXISTING FLOOR PLAN



REF: 4677SF_East_RTL
REV: 0
DRAWN BY: DS
AUDITED BY: TL

SHEET SIZE: 24x36
SCALE: 1/4"=1'-0"
FIELD MEASURE:
09/03/2025

AX-102
3 OF 5

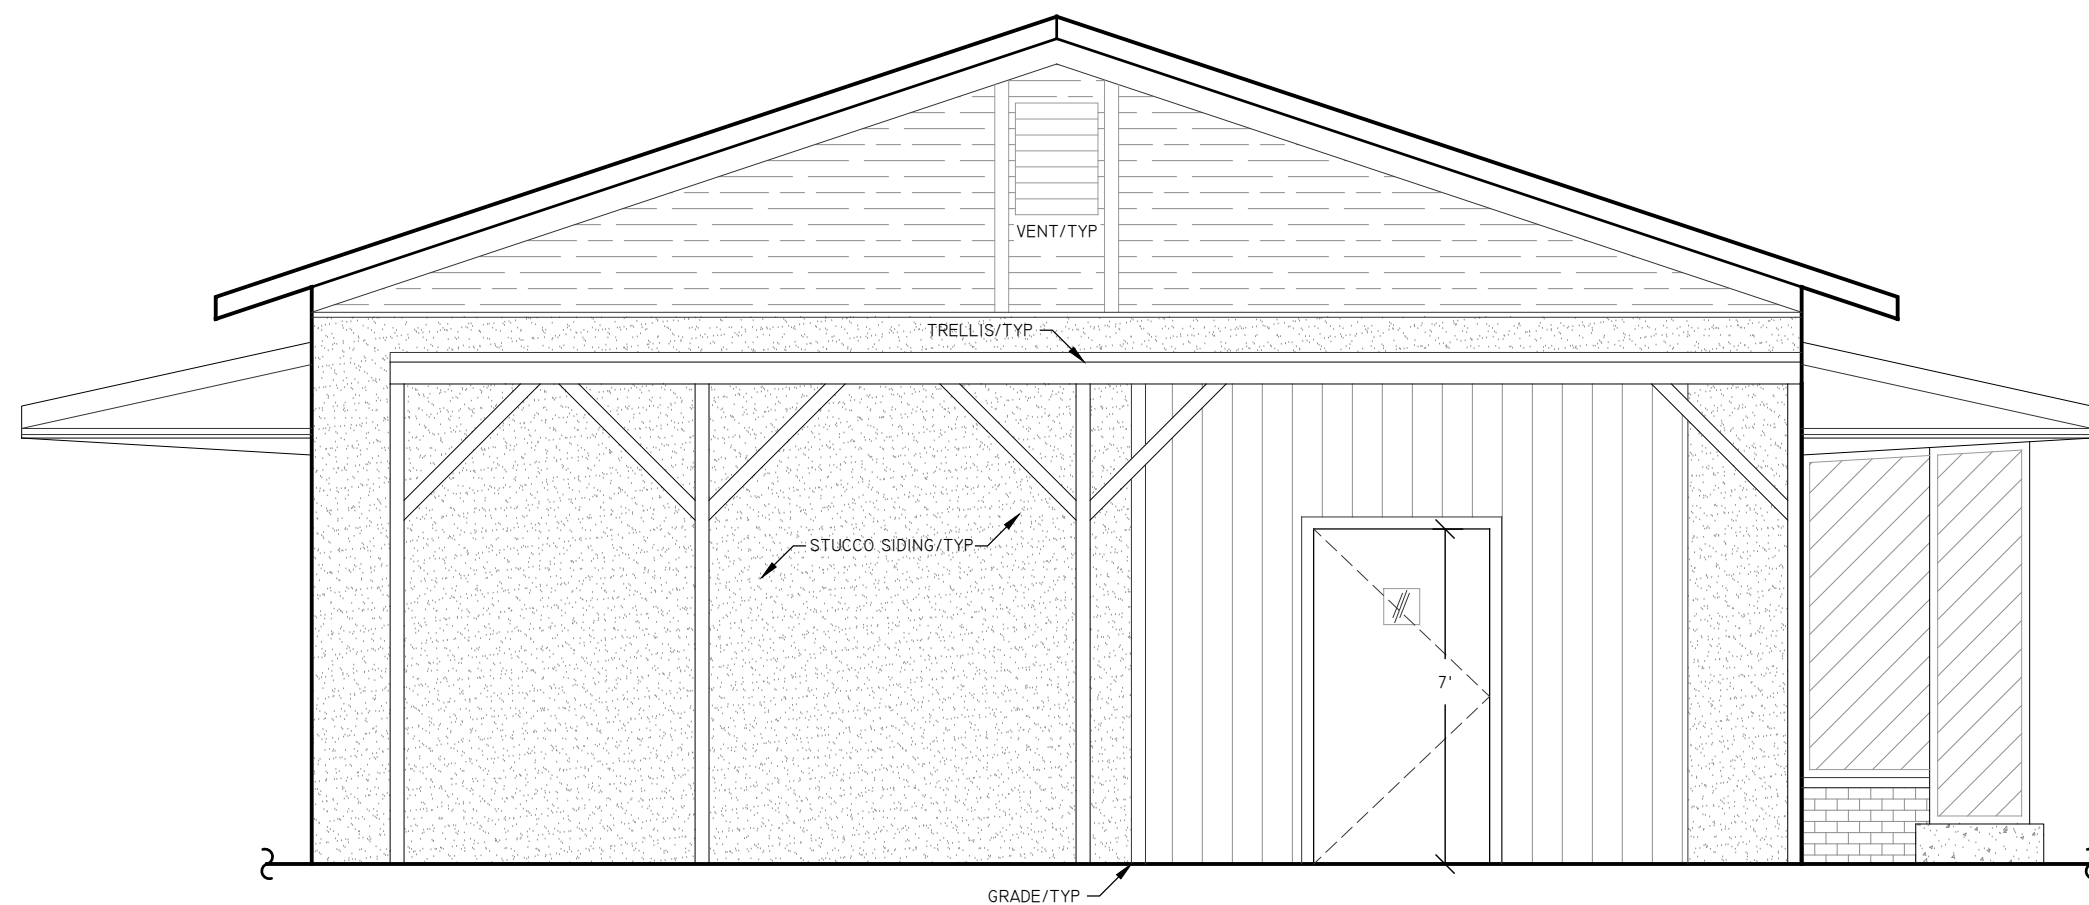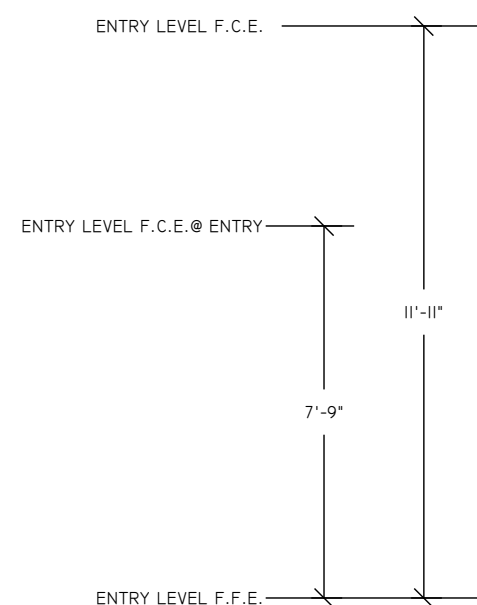


2 EXISTING NORTHWEST ELEVATION

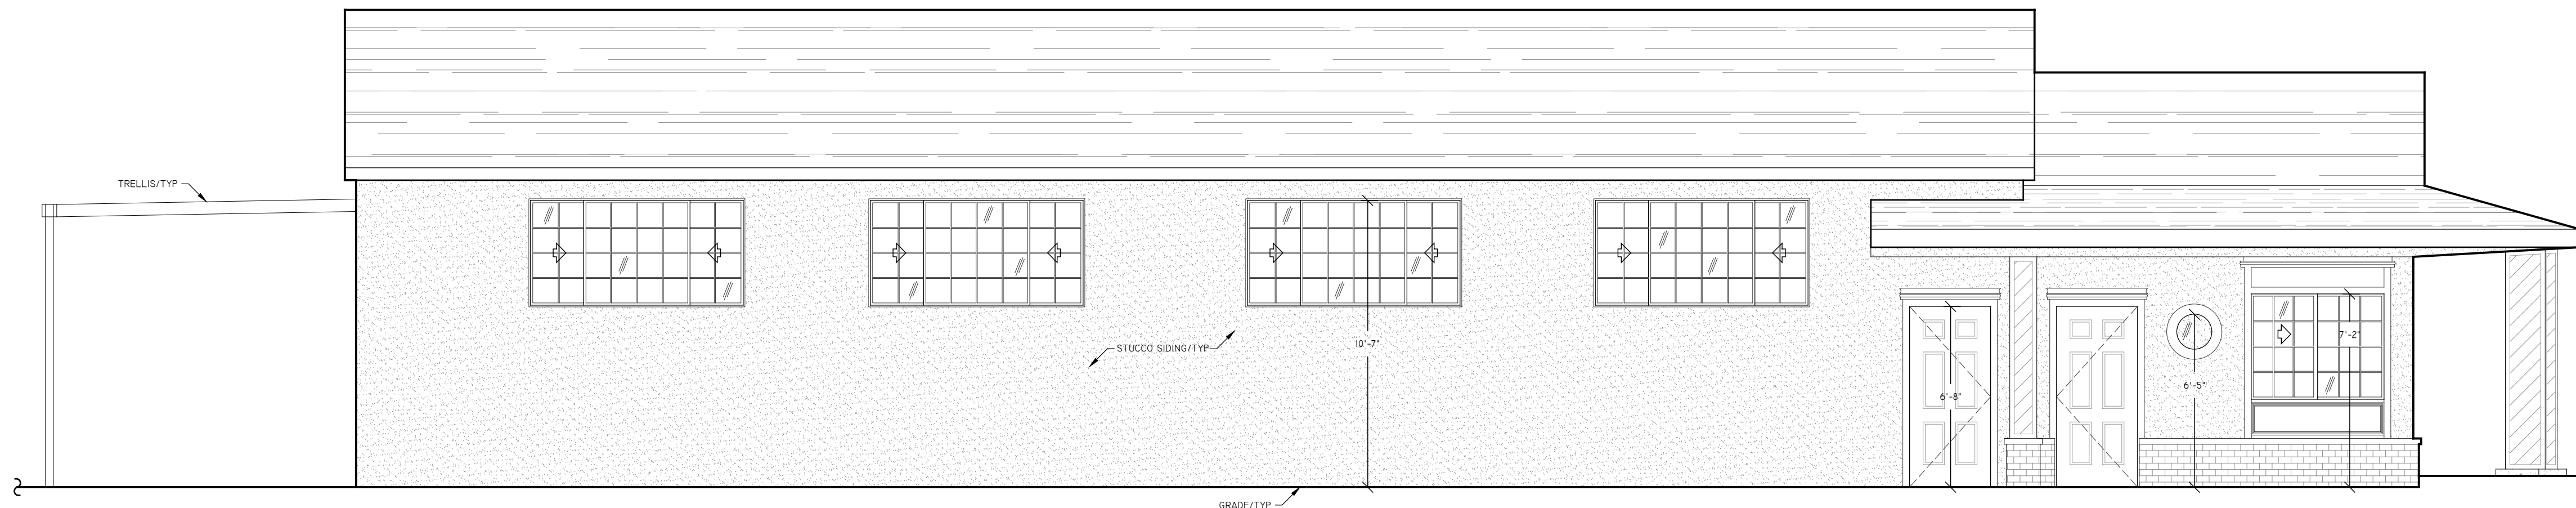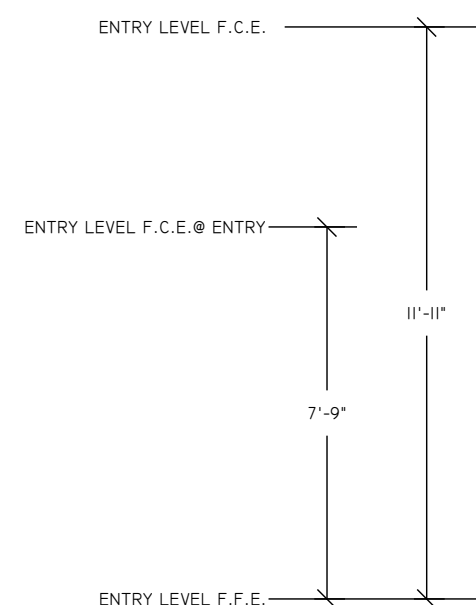

1 EXISTING SOUTHWEST ELEVATION

4677 PACHECO BOULEVARD
MARTINEZ, CA. 94553

THIS DRAWING IS A RECORD OF REAL PROPERTY
THAT IS GENERALLY ACCEPTED TO BE SUITABLE
FOR USE IN PLANNING, DESIGN, LEASE, AND
GENERAL ASSET MANAGEMENT. IT SHOULD NOT BE
USED TO DETERMINE EXACT MEASUREMENTS OF
SPACES OR ARTIFACTS FOUND HEREIN FOR ANY
PURPOSE.
EXTERIOR ELEMENTS HAVE BEEN MEASURED AND
DRAFTED FOR REFERENCE ONLY - THIS IS NOT A
SURVEY.

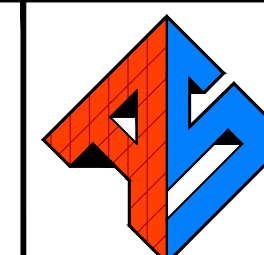


**ASBUILT
SERVICES**
FOR THE RECORD SINCE 1990
1-800-318-0099 ASBUILTSERVICES.COM

EXISTING EXTERIOR ELEVATIONS


REF: 4677SF_East_RTL
REV: 0
DRAWN BY: DS
AUDITED BY: TL

SHEET SIZE: 24x36
SCALE: 1/4"=1'-0"
FIELD MEASURE:
09/03/2023

AX-201
4 OF 5

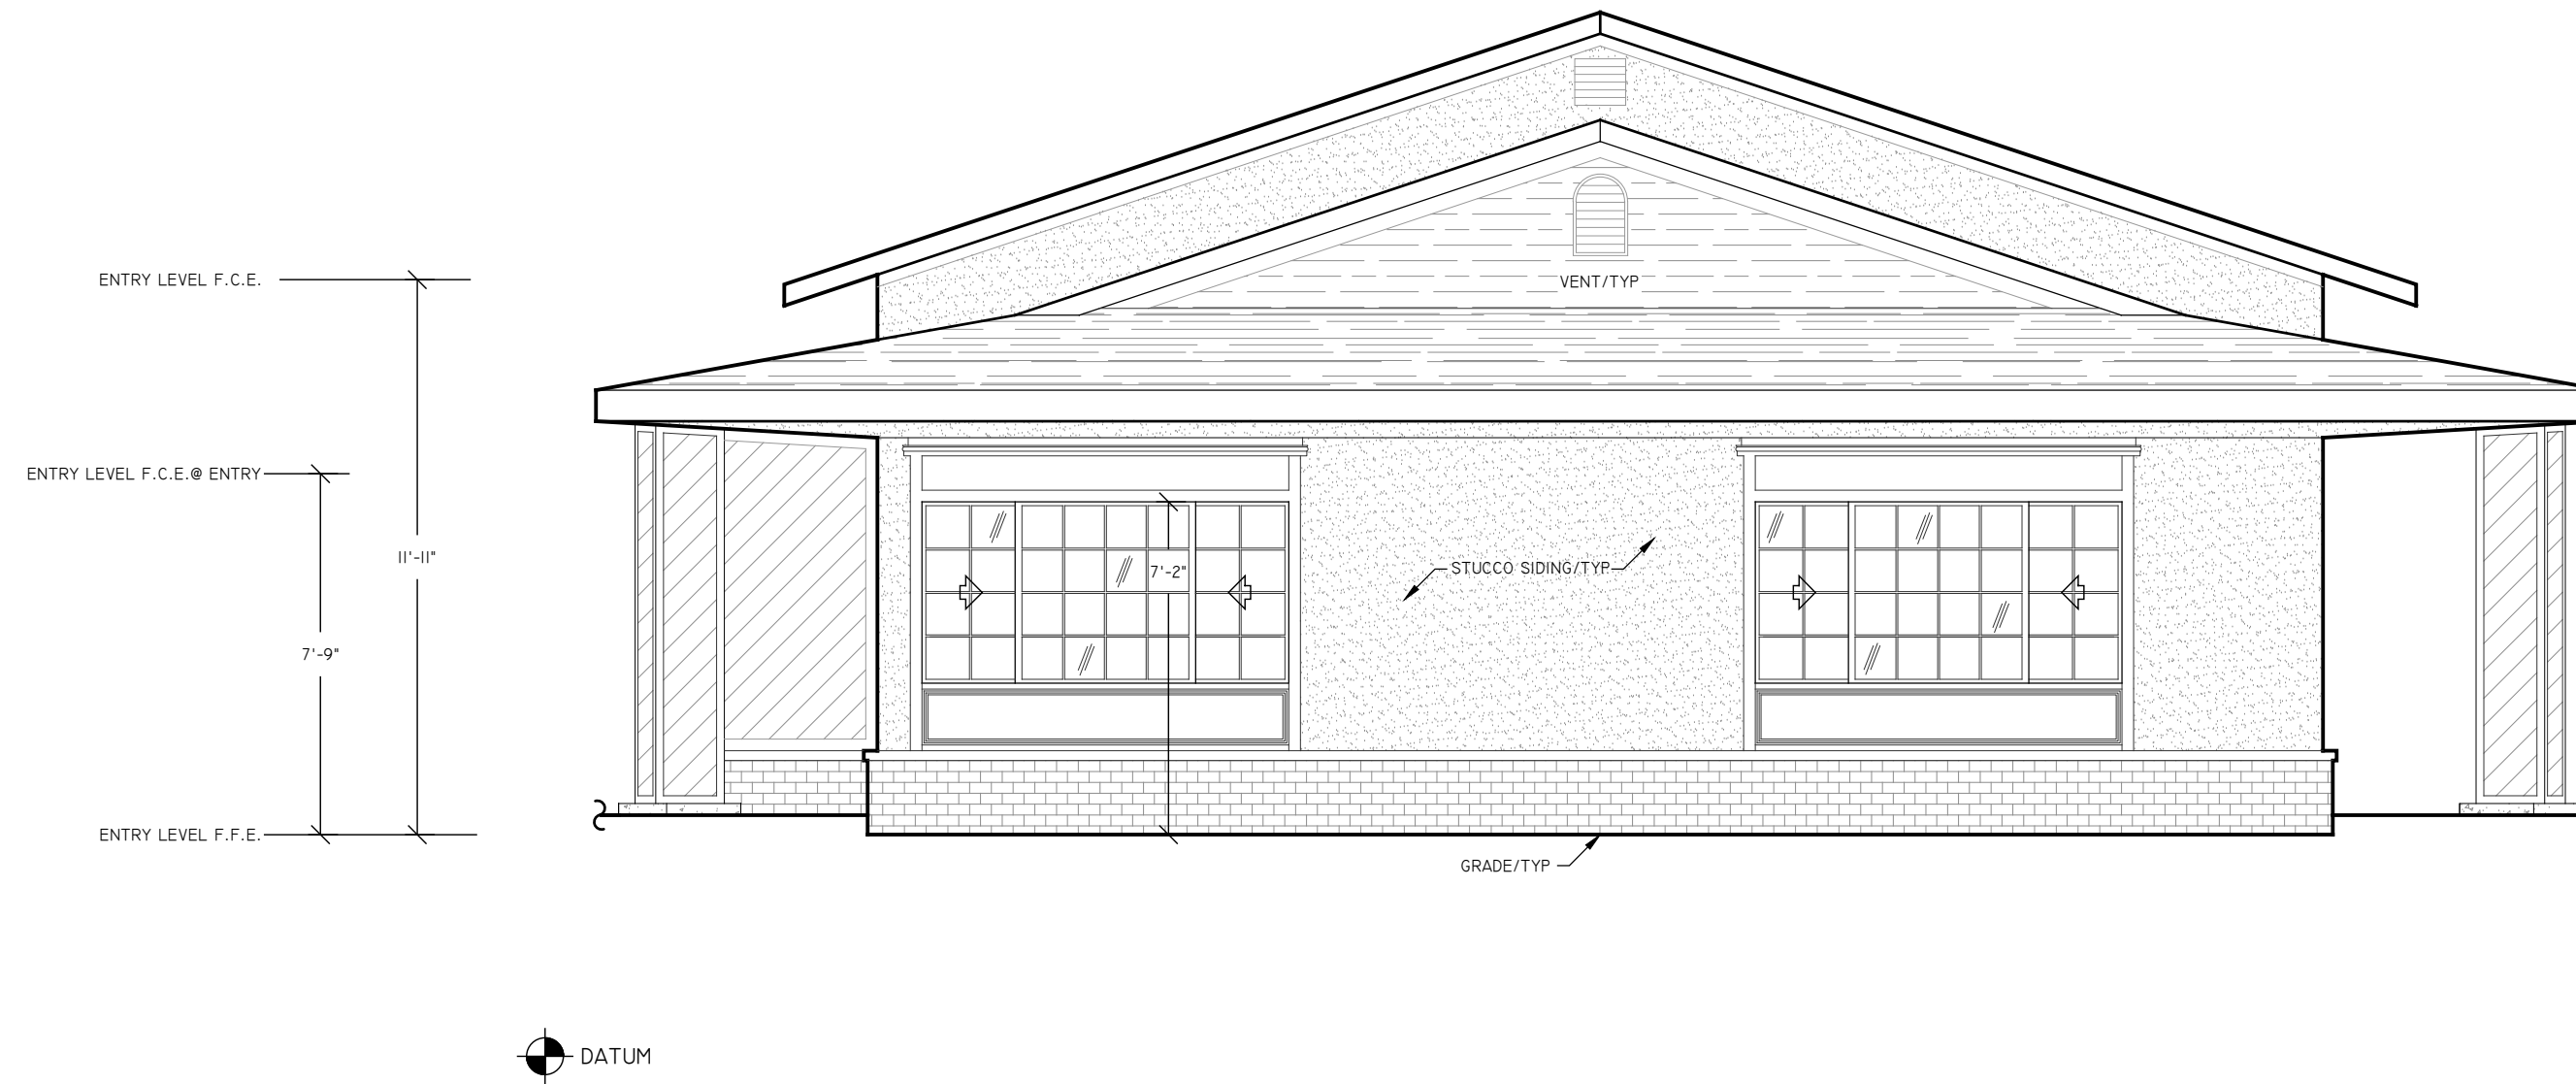

② EXISTING SOUTHEAST ELEVATION

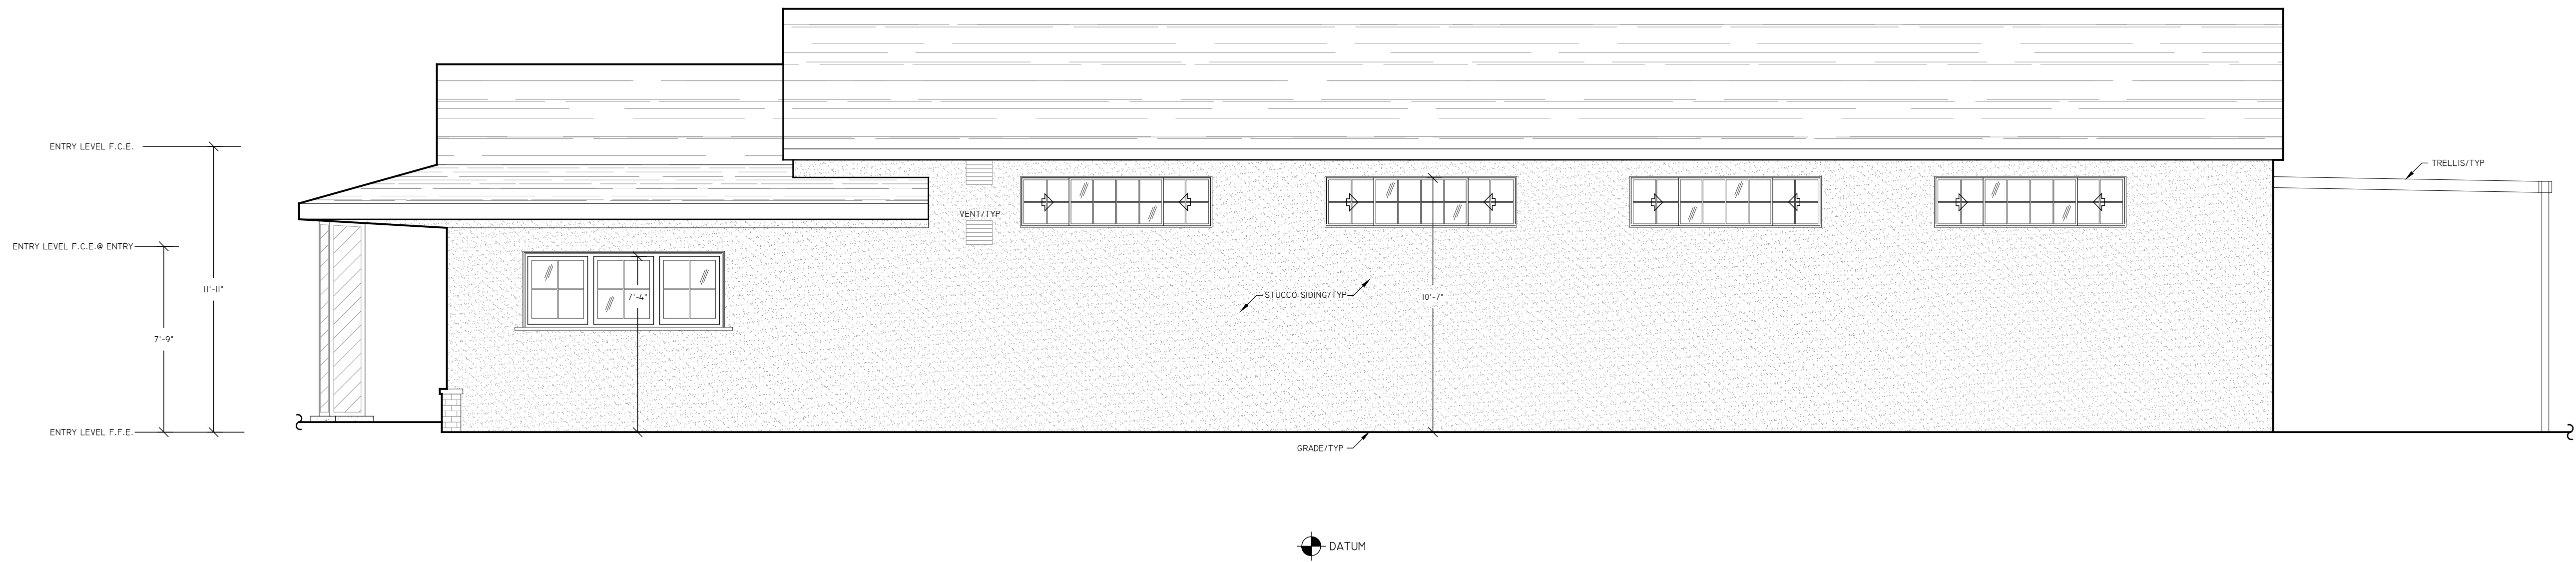

① EXISTING NORTHEAST ELEVATION

4677 PACHECO BOULEVARD
MARTINEZ, CA. 94553

THIS DRAWING IS A RECORD OF REAL PROPERTY
THAT IS GENERALLY ACCEPTED TO BE SUITABLE
FOR USE IN PLANNING, DESIGN, LEASE, AND
GENERAL ASSET MANAGEMENT. IT SHOULD NOT BE
USED TO DETERMINE EXACT MEASUREMENTS OF
SPACES OR ARTIFACTS FOUND HEREIN FOR ANY
PURPOSE.
EXTERIOR ELEMENTS HAVE BEEN MEASURED AND
DRAFTED FOR REFERENCE ONLY - THIS IS NOT A
SURVEY.



1-800-318-0099 ASBUILTSERVICES.COM

EXISTING EXTERIOR ELEVATIONS

REF: 4677SF_East_RTL
REV: 0
DRAWN BY: DS
AUDITED BY: TL

SHEET SIZE: 24x36
SCALE: 1/4"=1'-0"
FIELD MEASURE:
09/03/2023

AX-202
5 OF 5