






5728 Del Monte Av El Cerrito Ca
ROB NUNALLY

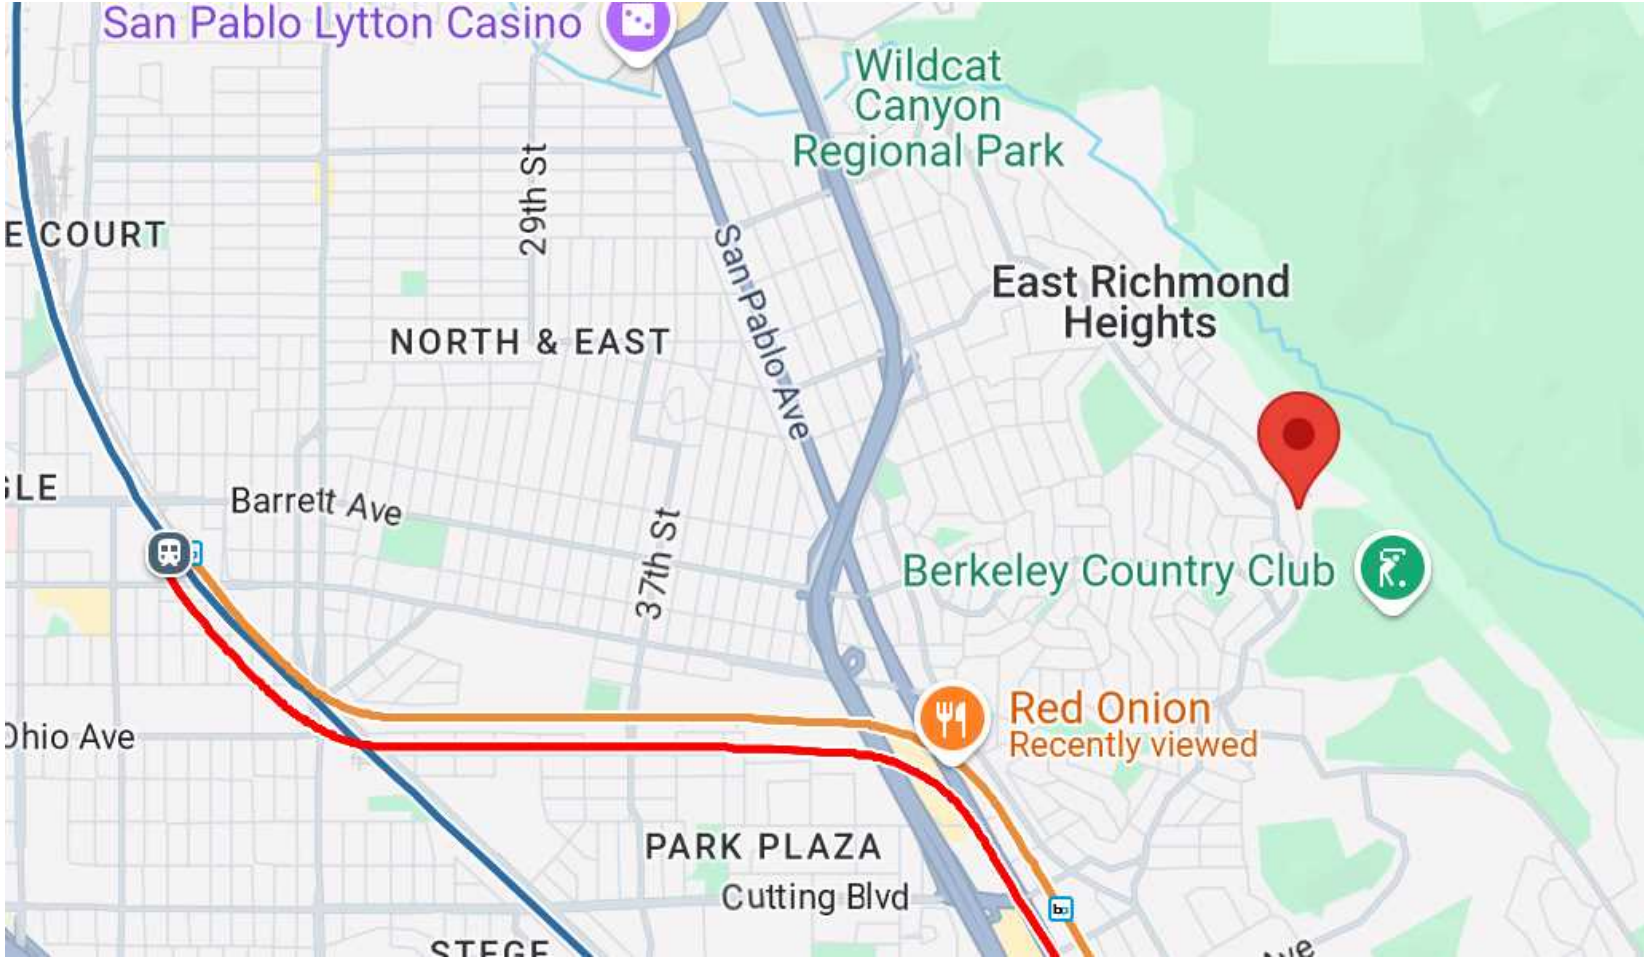

REVISIONS	
NO.	REMARKS
1	9/12/24
2	
3	
4	
5	October 19, 2024

The Greg Phipps Company
 2758 Del Monte AV El Cerrito CA



2758 Del Monte Av
Renovation

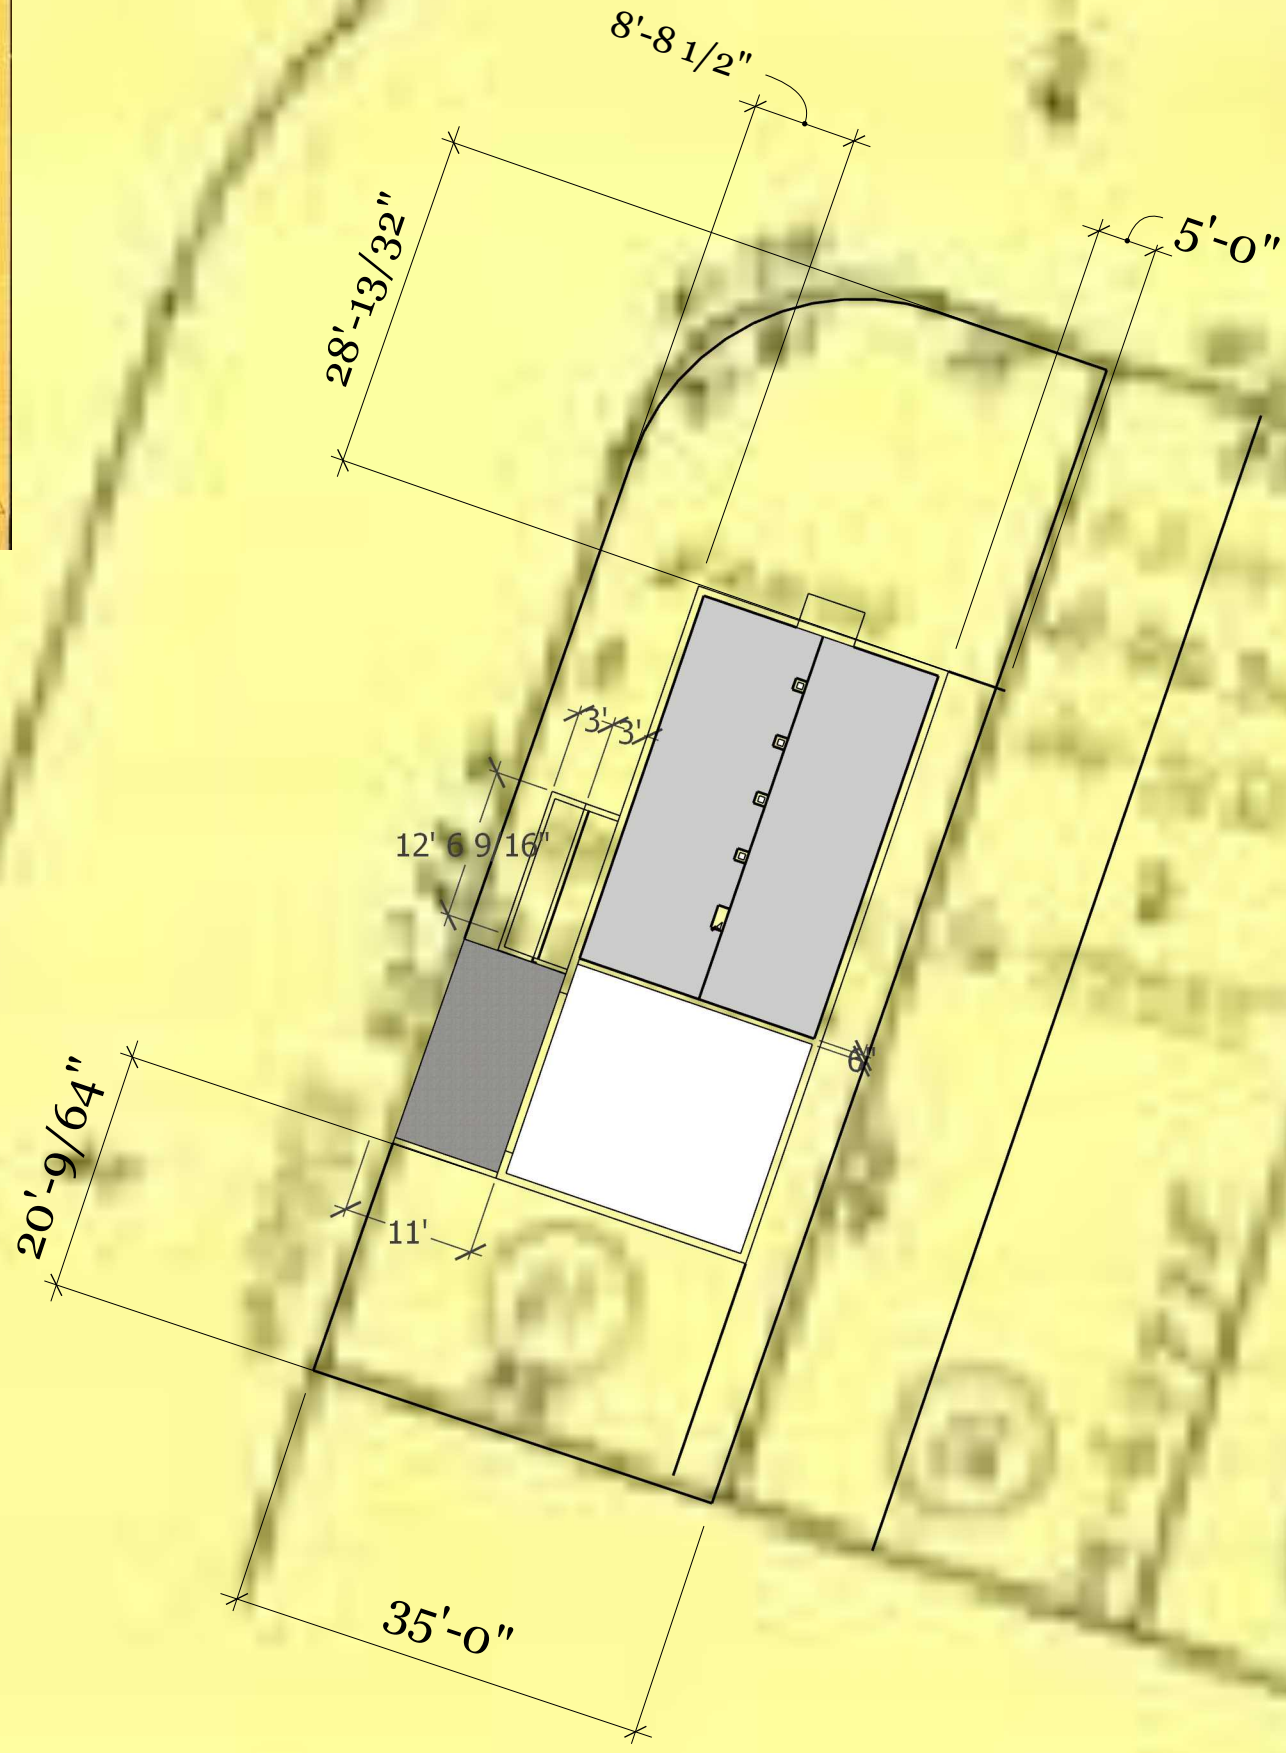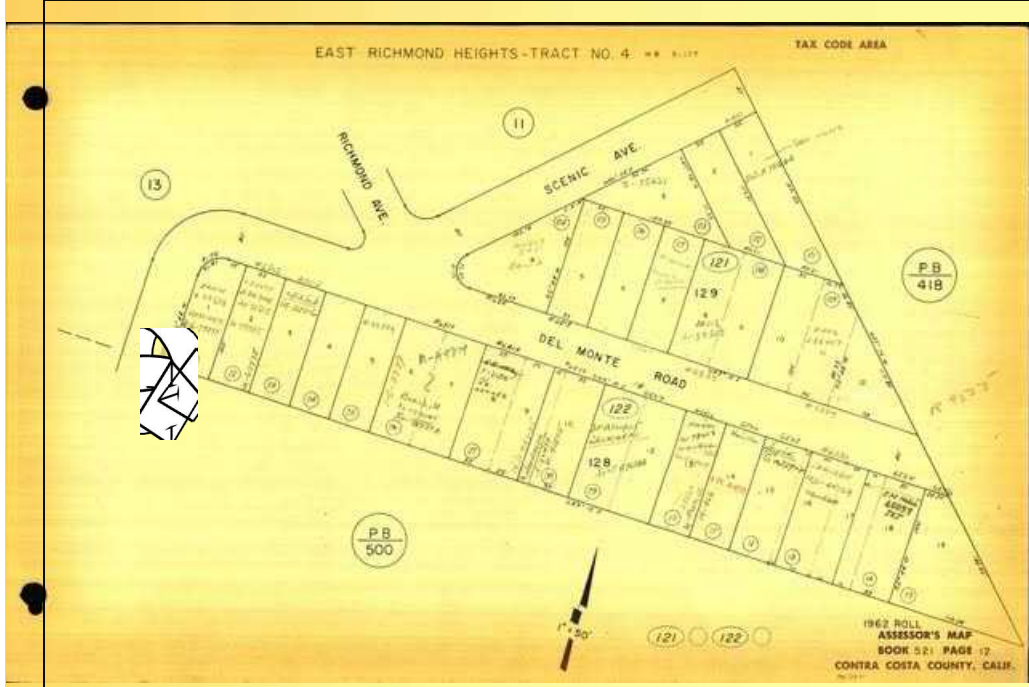

REVISIONS	
NO.	REMARKS
1	9/12/24
2	...
3	...
4	...
5	...

Site Plan



2758 Del Monte AV El Cerrito CA

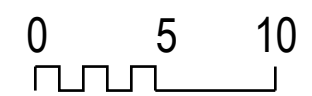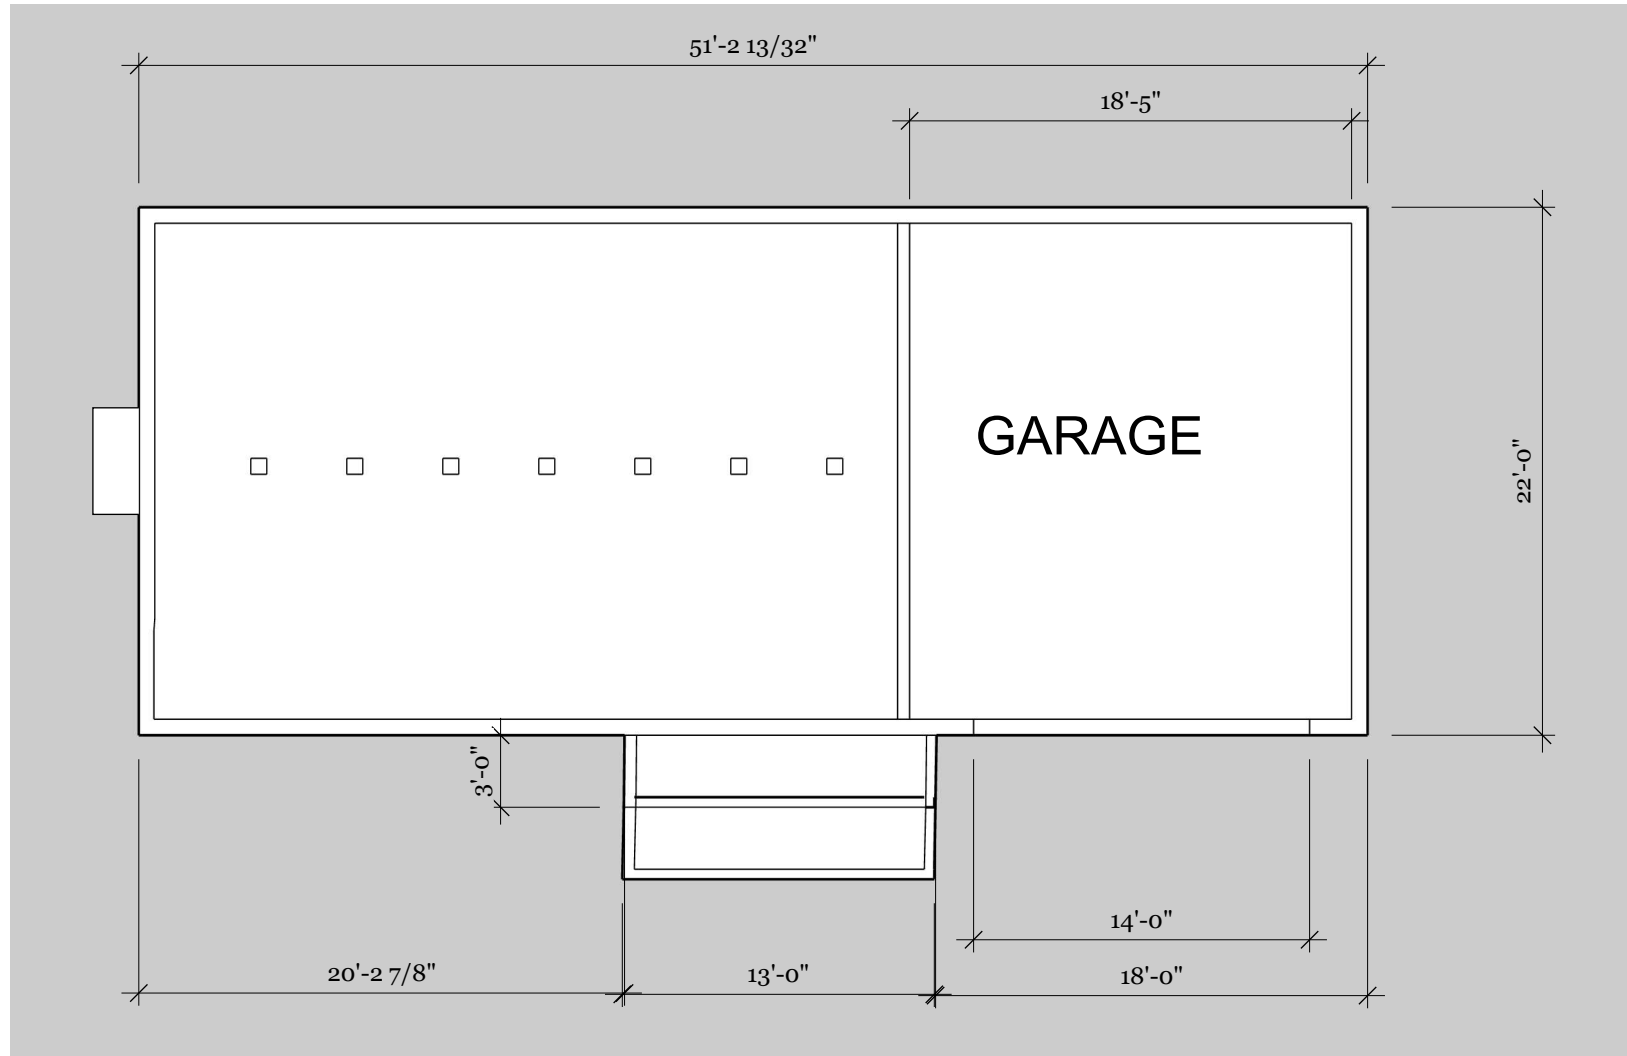

REVISIONS	
NO.	REMARKS
1	9/12/24
2	...
3	...
4	...
5	...

2758 Del Monte AV El Cerrito CA


**AS BUILT
FOUNDATION**

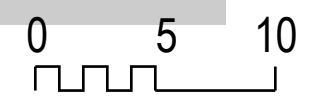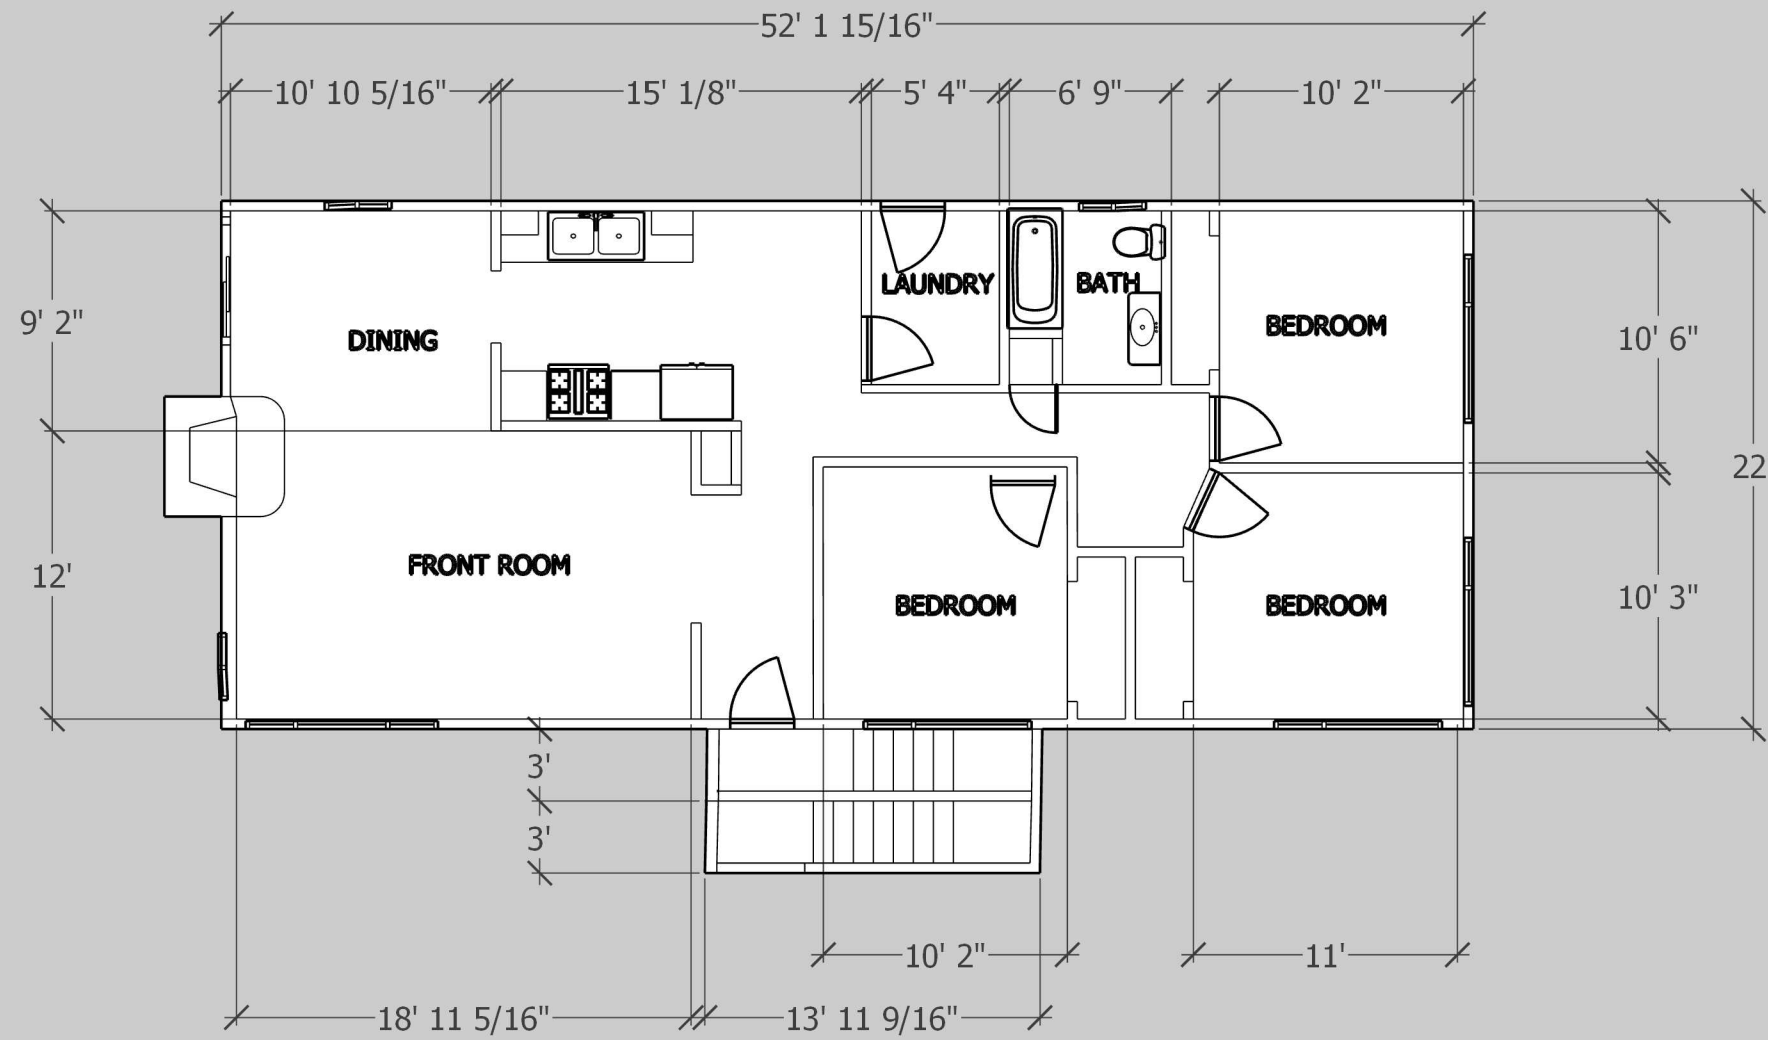


REVISIONS	
NO.	REMARKS
1	9/12/24
2	...
3	...
4	...
5	...

2758 Del Monte AV El Cerrito CA

AS BUILT MAIN FLOOR

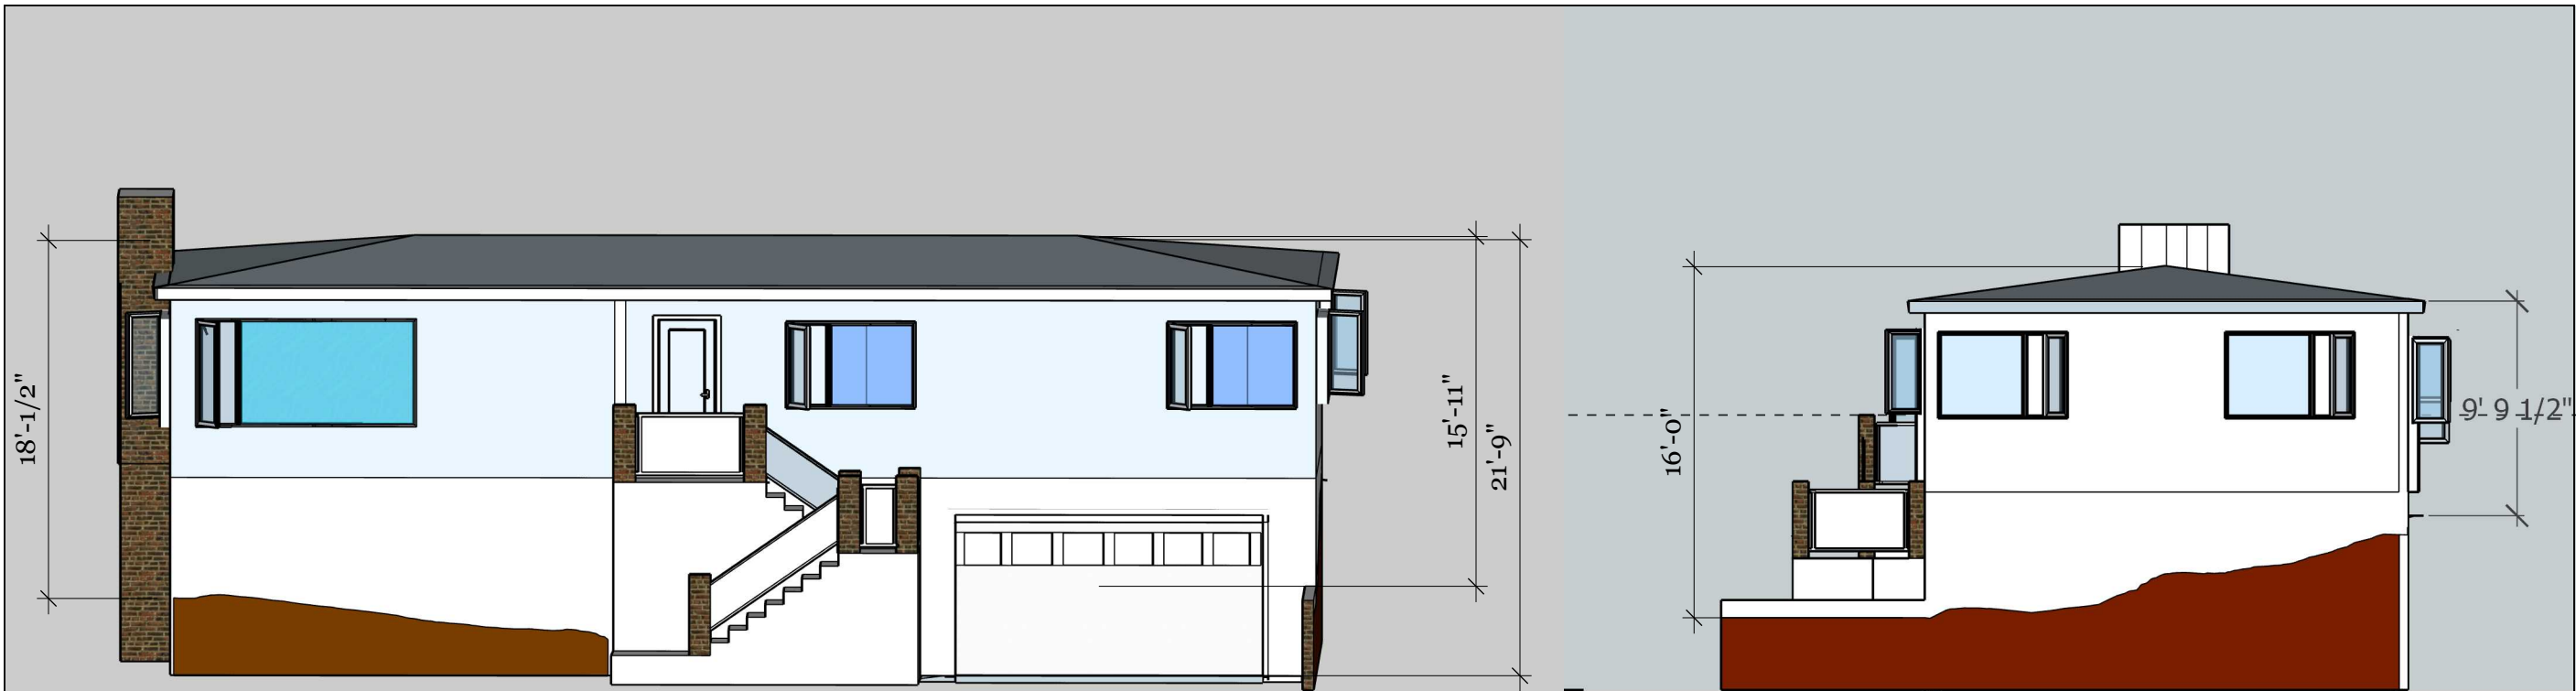


SOUTH

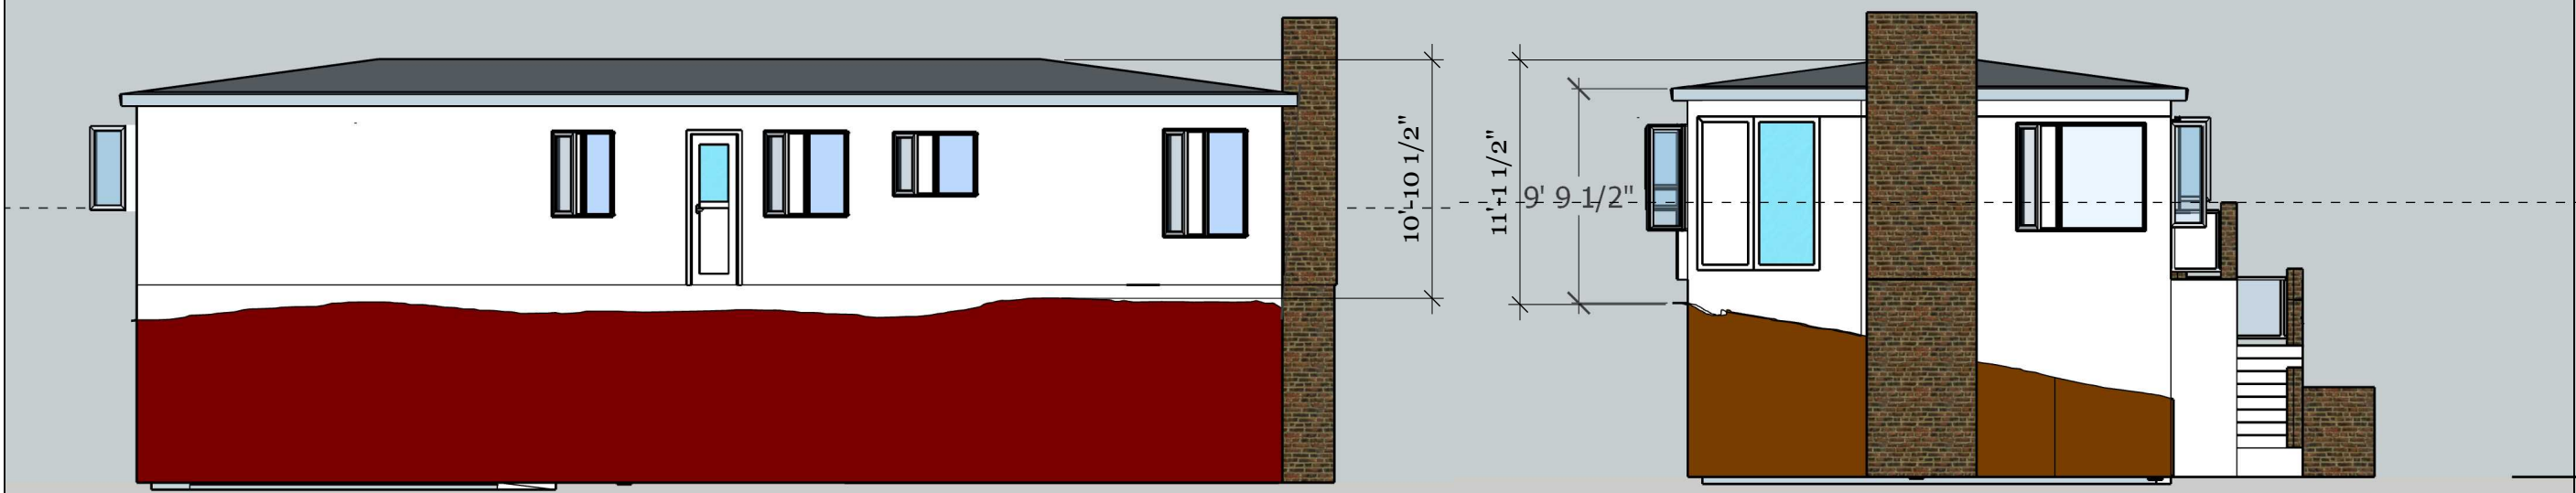

BACK



NORTH

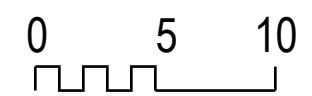

REVISIONS	
NO.	REMARKS
1	9/22/24
2	...
3	...
4	...
5	...

2758 Del Monte AV El Cerrito CA



AS BUILT ELEVATIONS

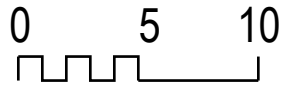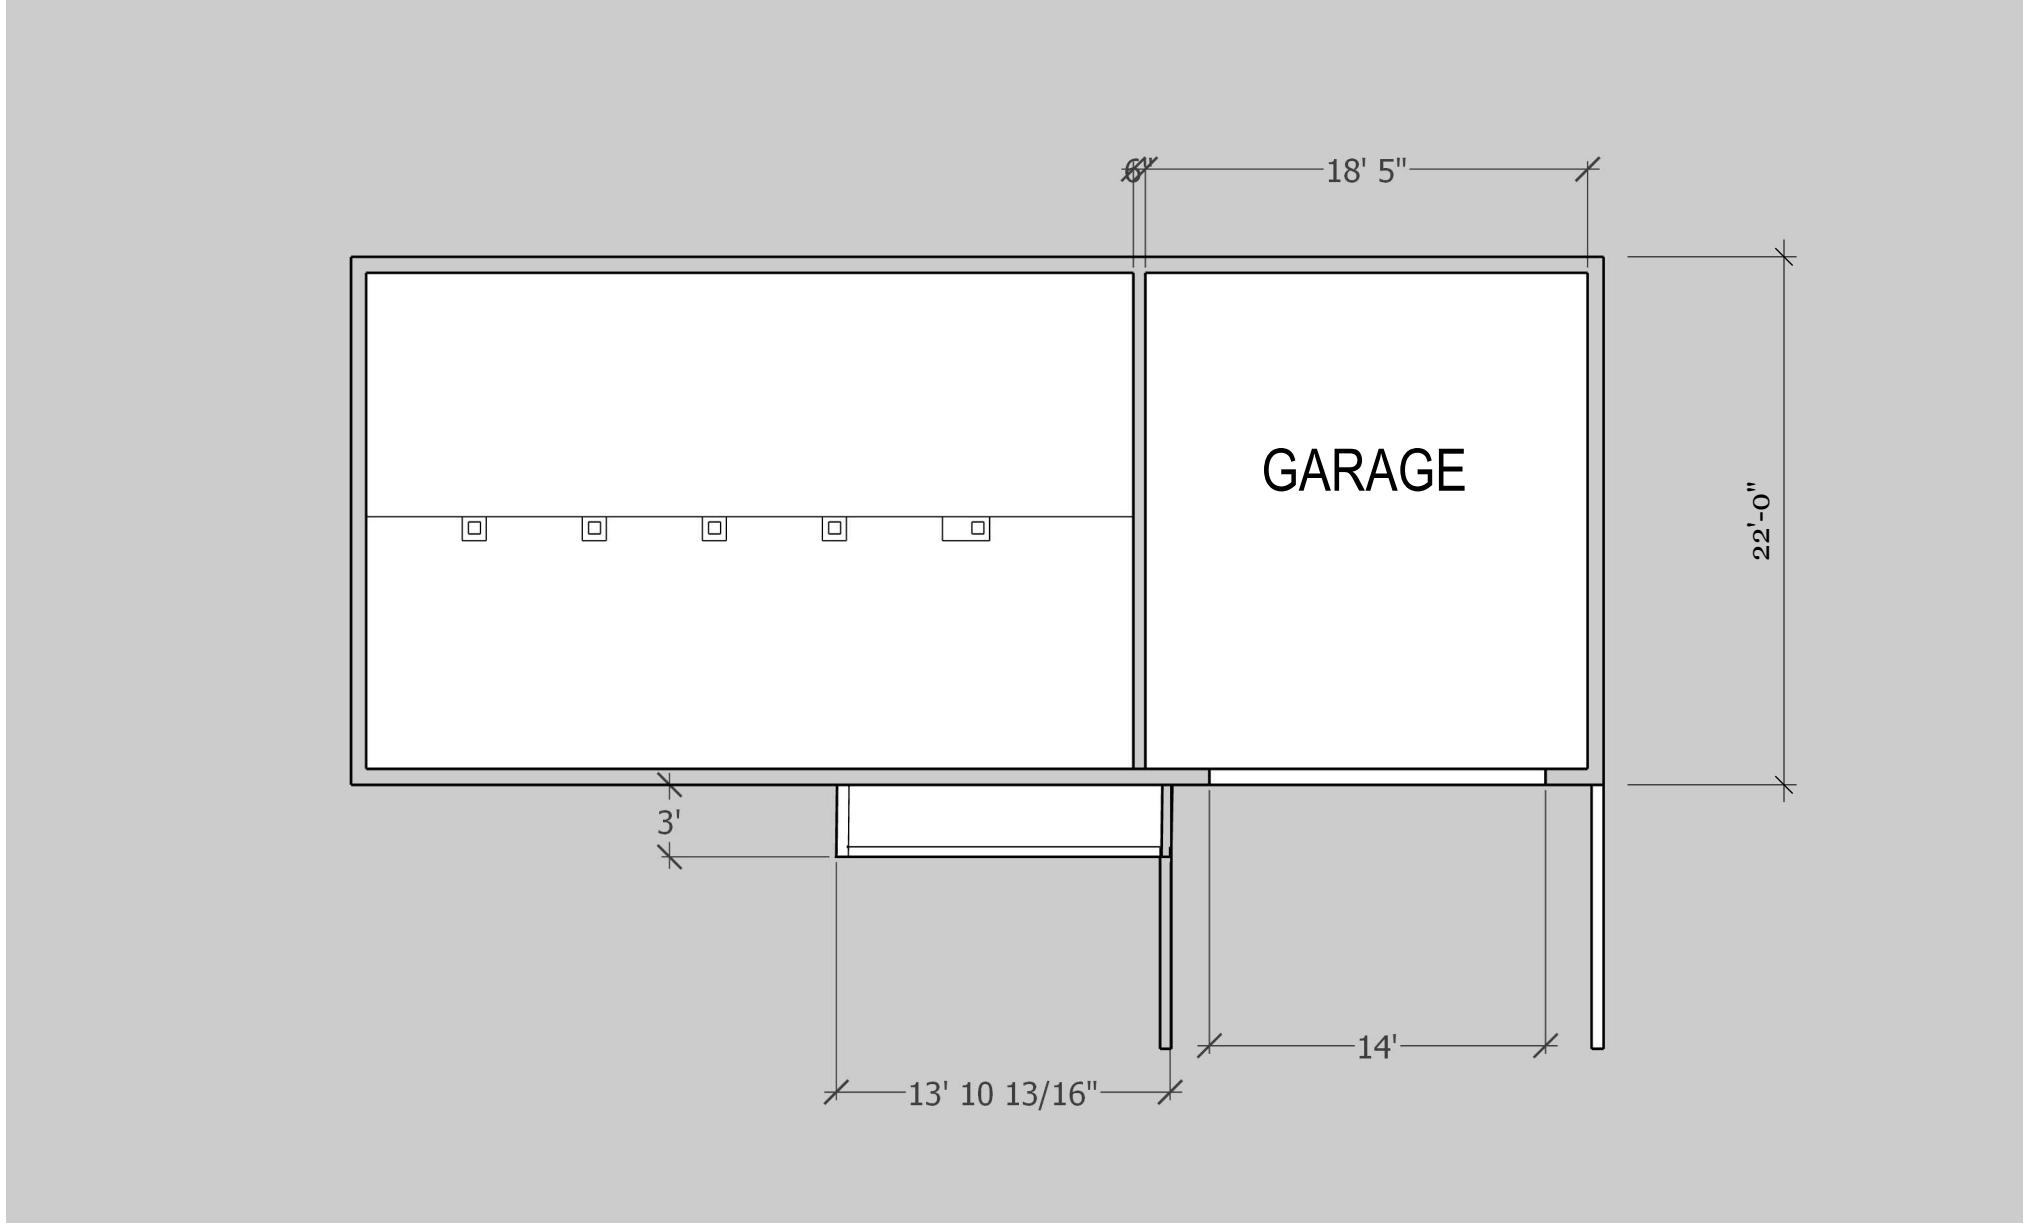

REVISIONS	
NO.	REMARKS
1	9/12/24
2	...
3	...
4	...
5	...

2758 Del Monte AV El Cerrito CA



**No Change of
FOUNDATION**

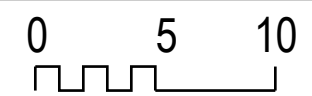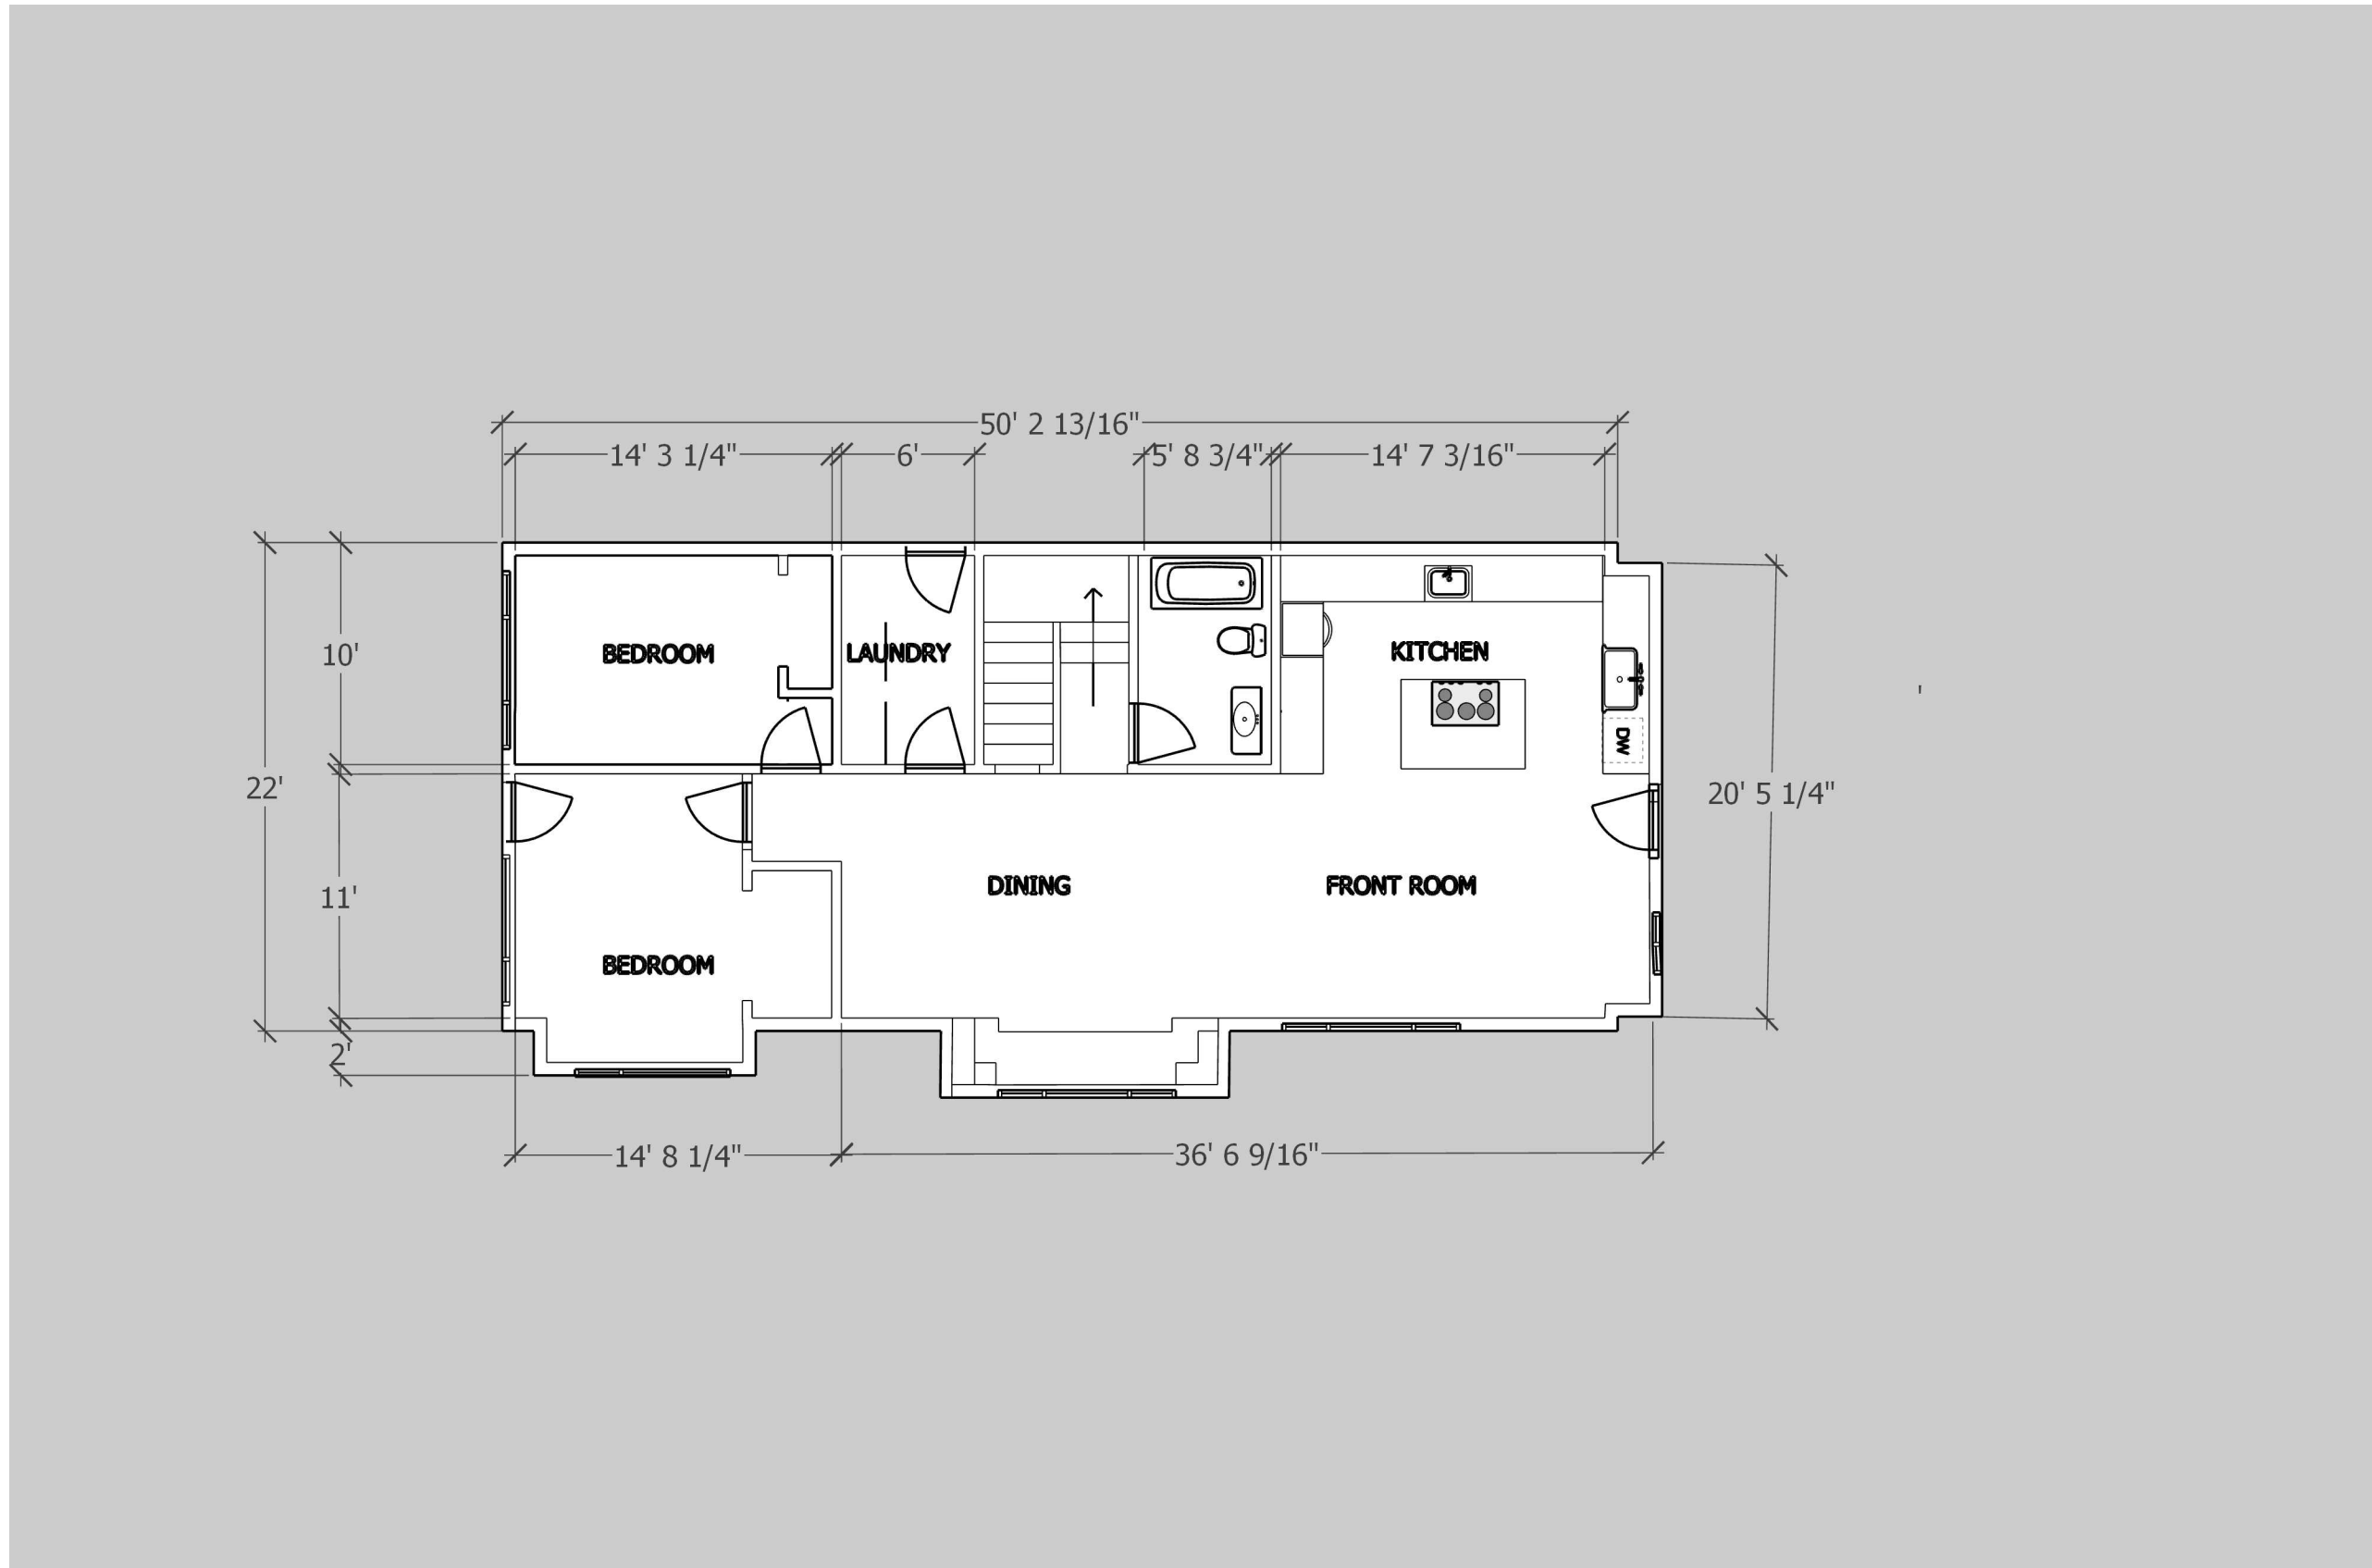

REVISIONS	
NO.	REMARKS
1	9/12/24
2	...
3	...
4	...
5	...

2758 Del Monte AV El Cerrito CA

**Proposed
Main Floor**

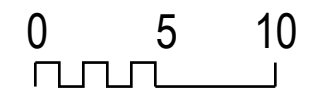
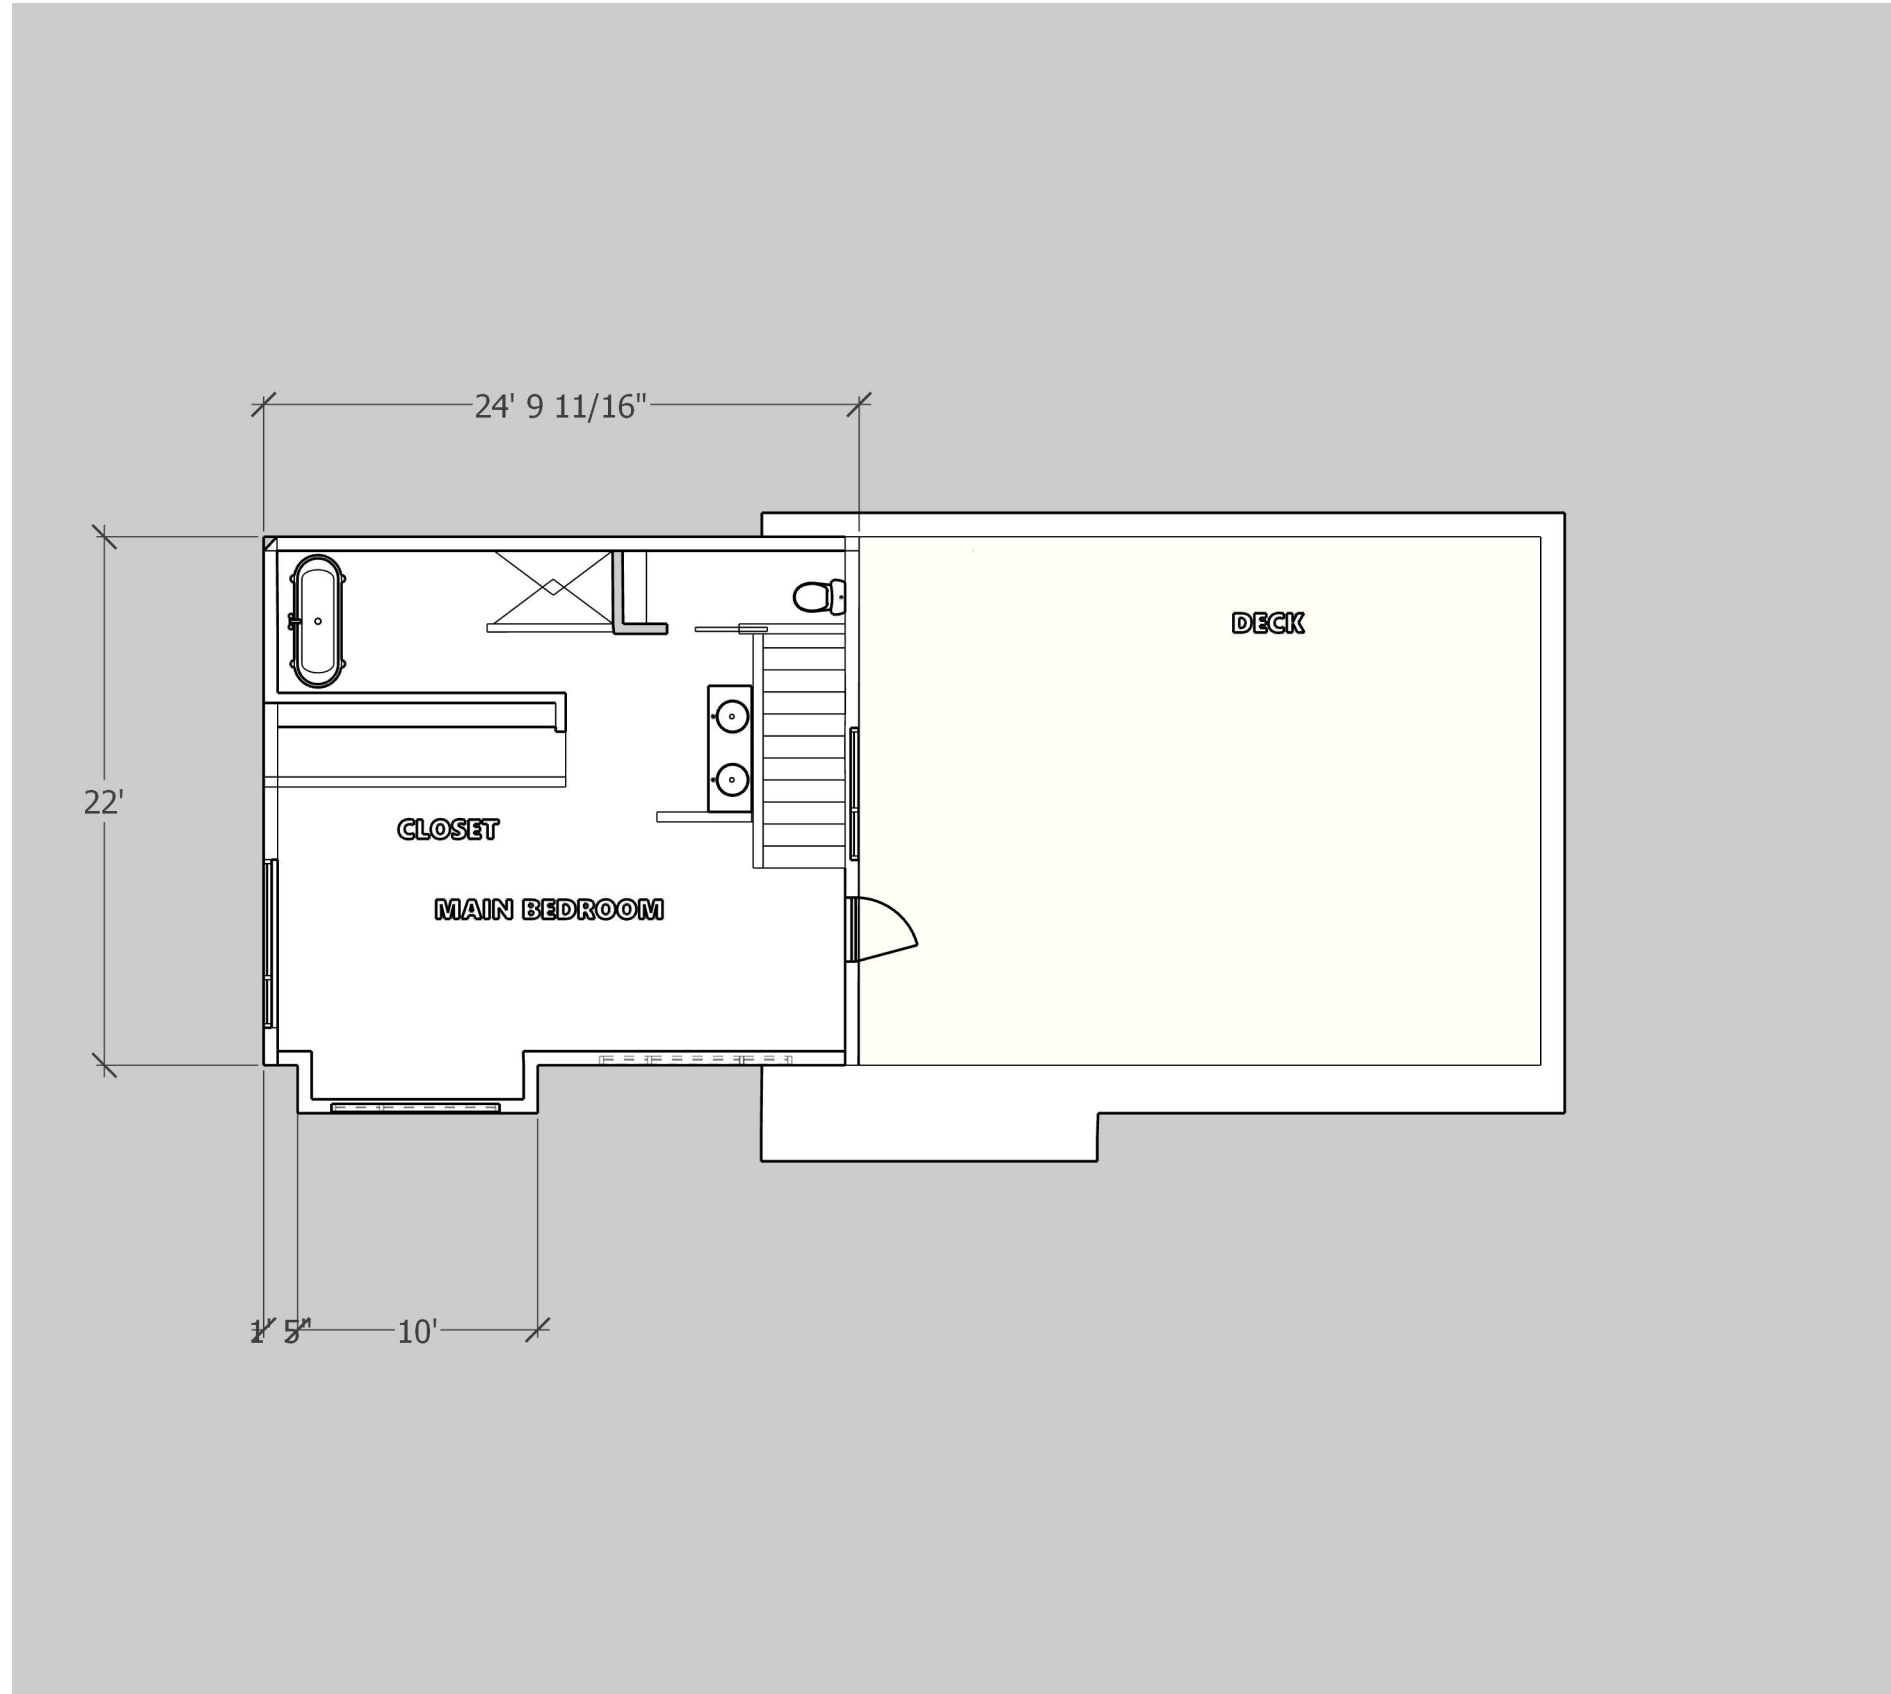


**Proposed
MAIN BEDROOM**

2758 Del Monte AV El Cerrito CA

REVISIONS


	9/12/24	REMARKS
1	---	...
2	---	...
3	---	...
4	---	...
5	---	...

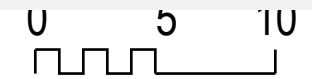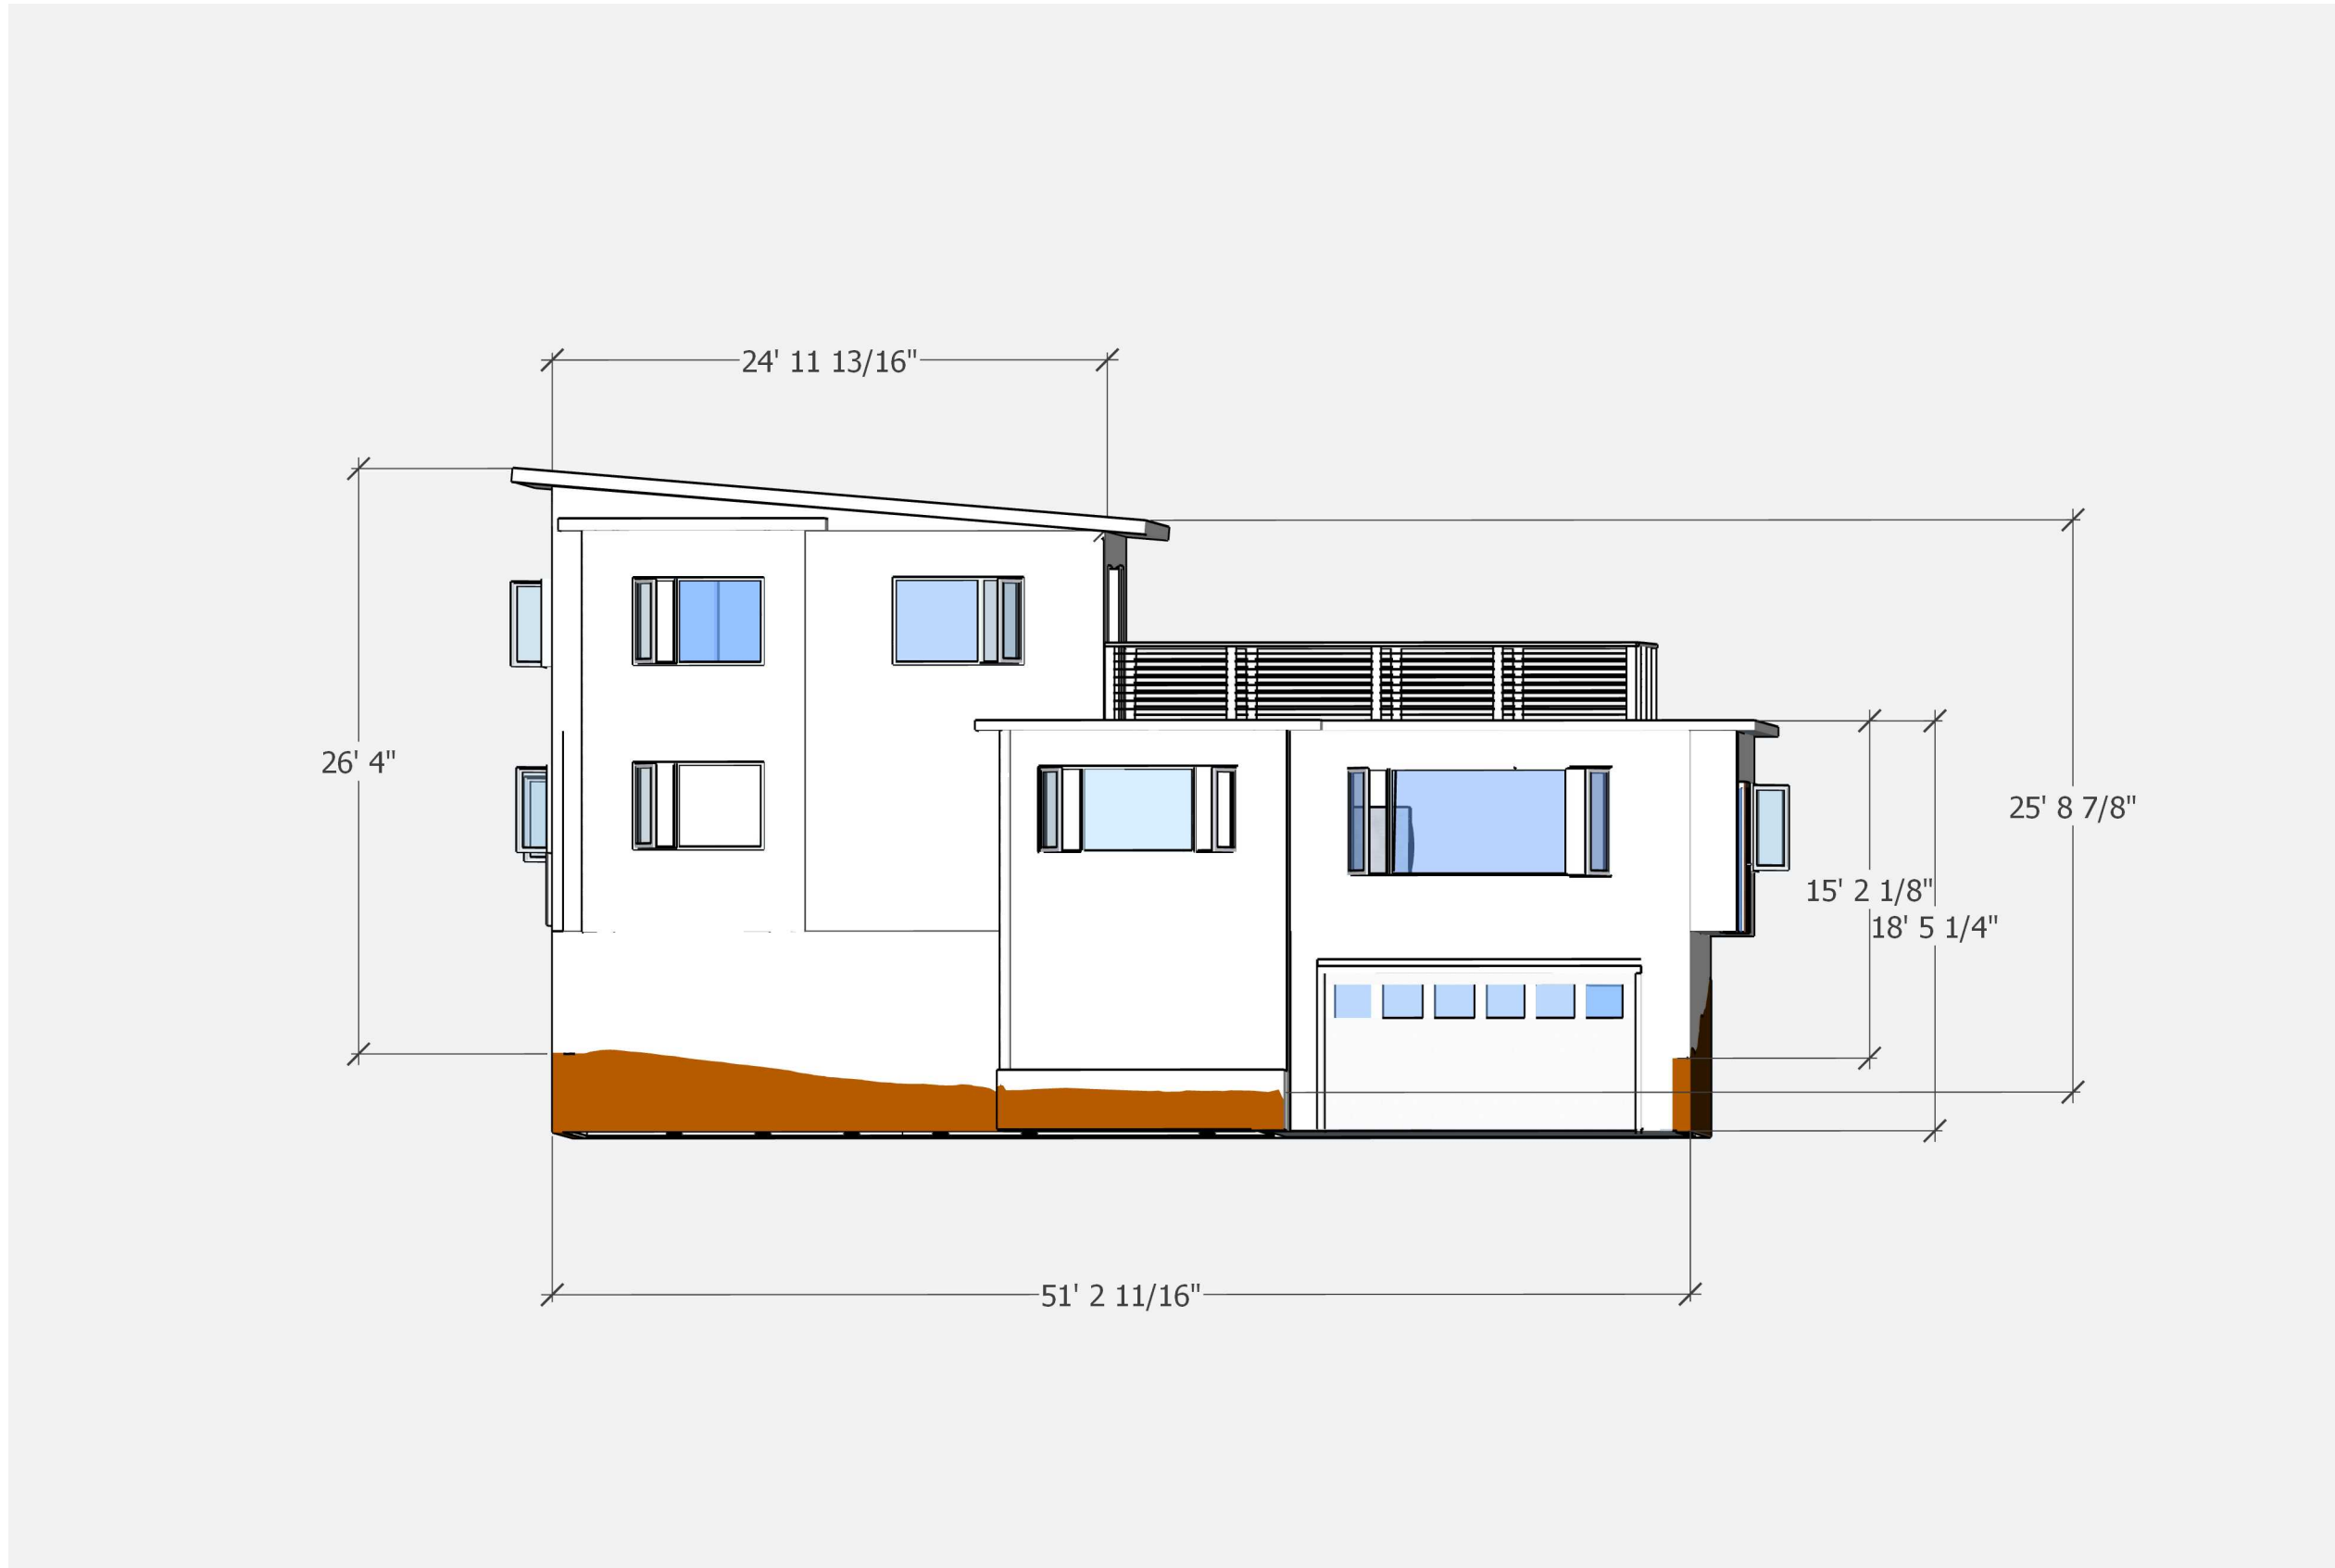


REVISIONS	
NO.	REMARKS
1	9/12/24
2	
3	
4	
5	

2758 Del Monte AV El Cerrito CA

**Proposed
FRONT elevation**

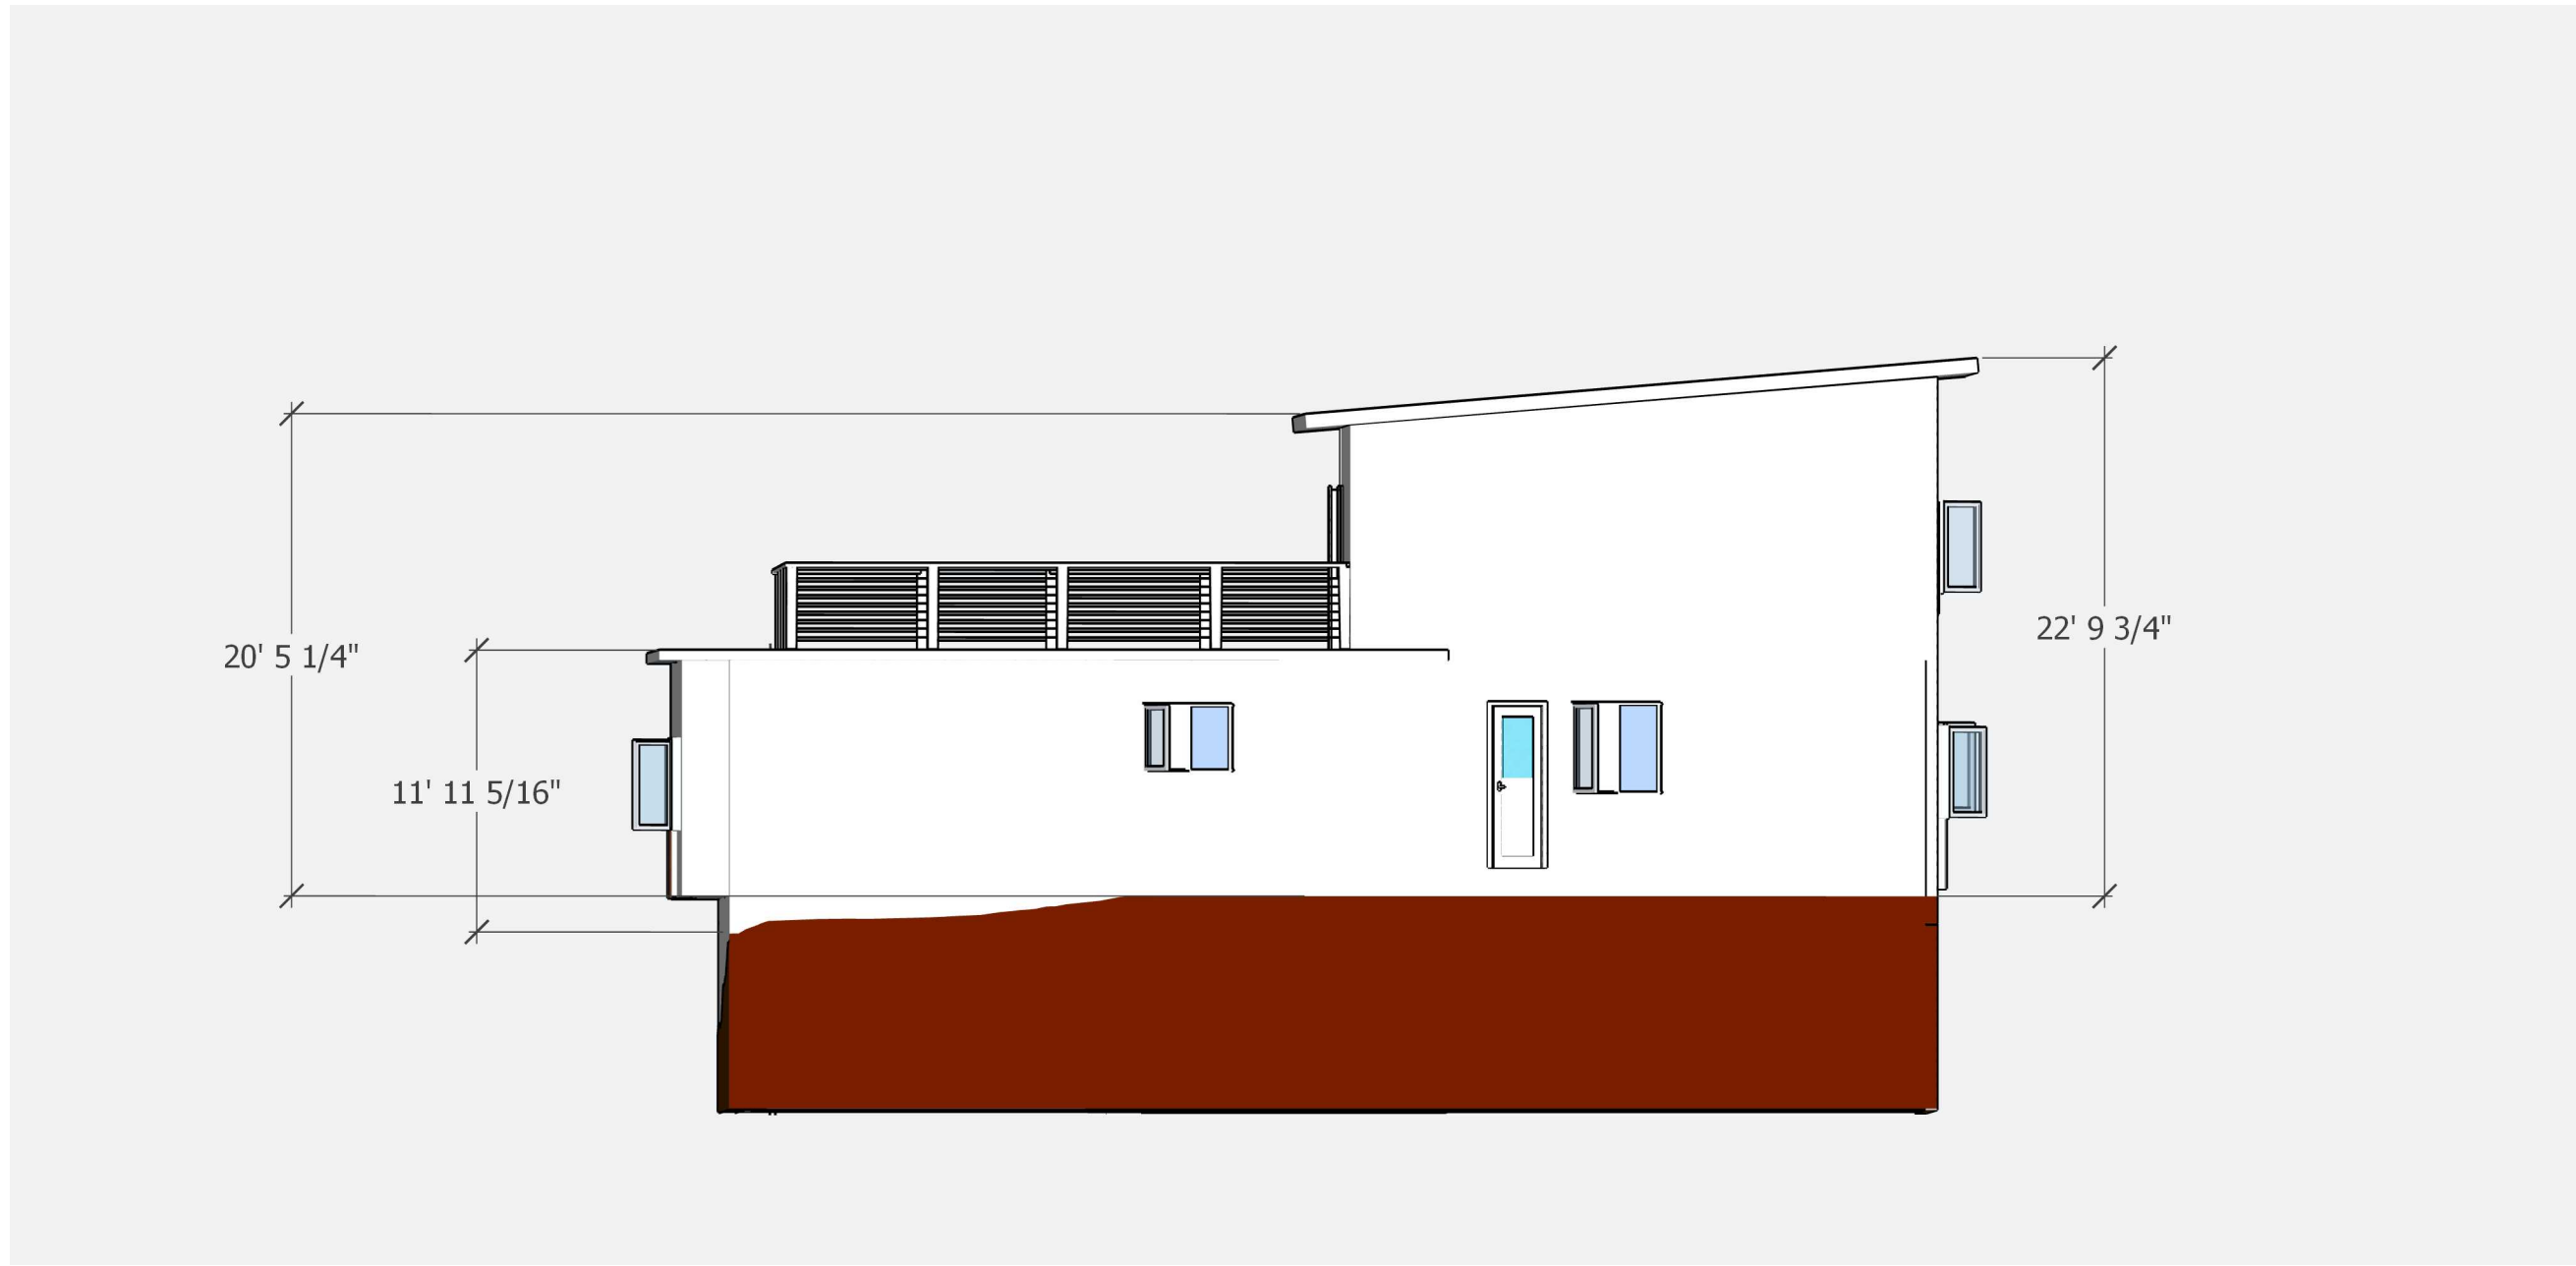

BACK

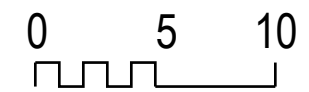


REVISIONS

	9/12/24	REMARKS
1	---	...
2	---	...
3	---	...
4	---	...
5	---	...

2758 Del Monte AV El Cerrito CA


**Proposed
BACK elevation**

A | 09

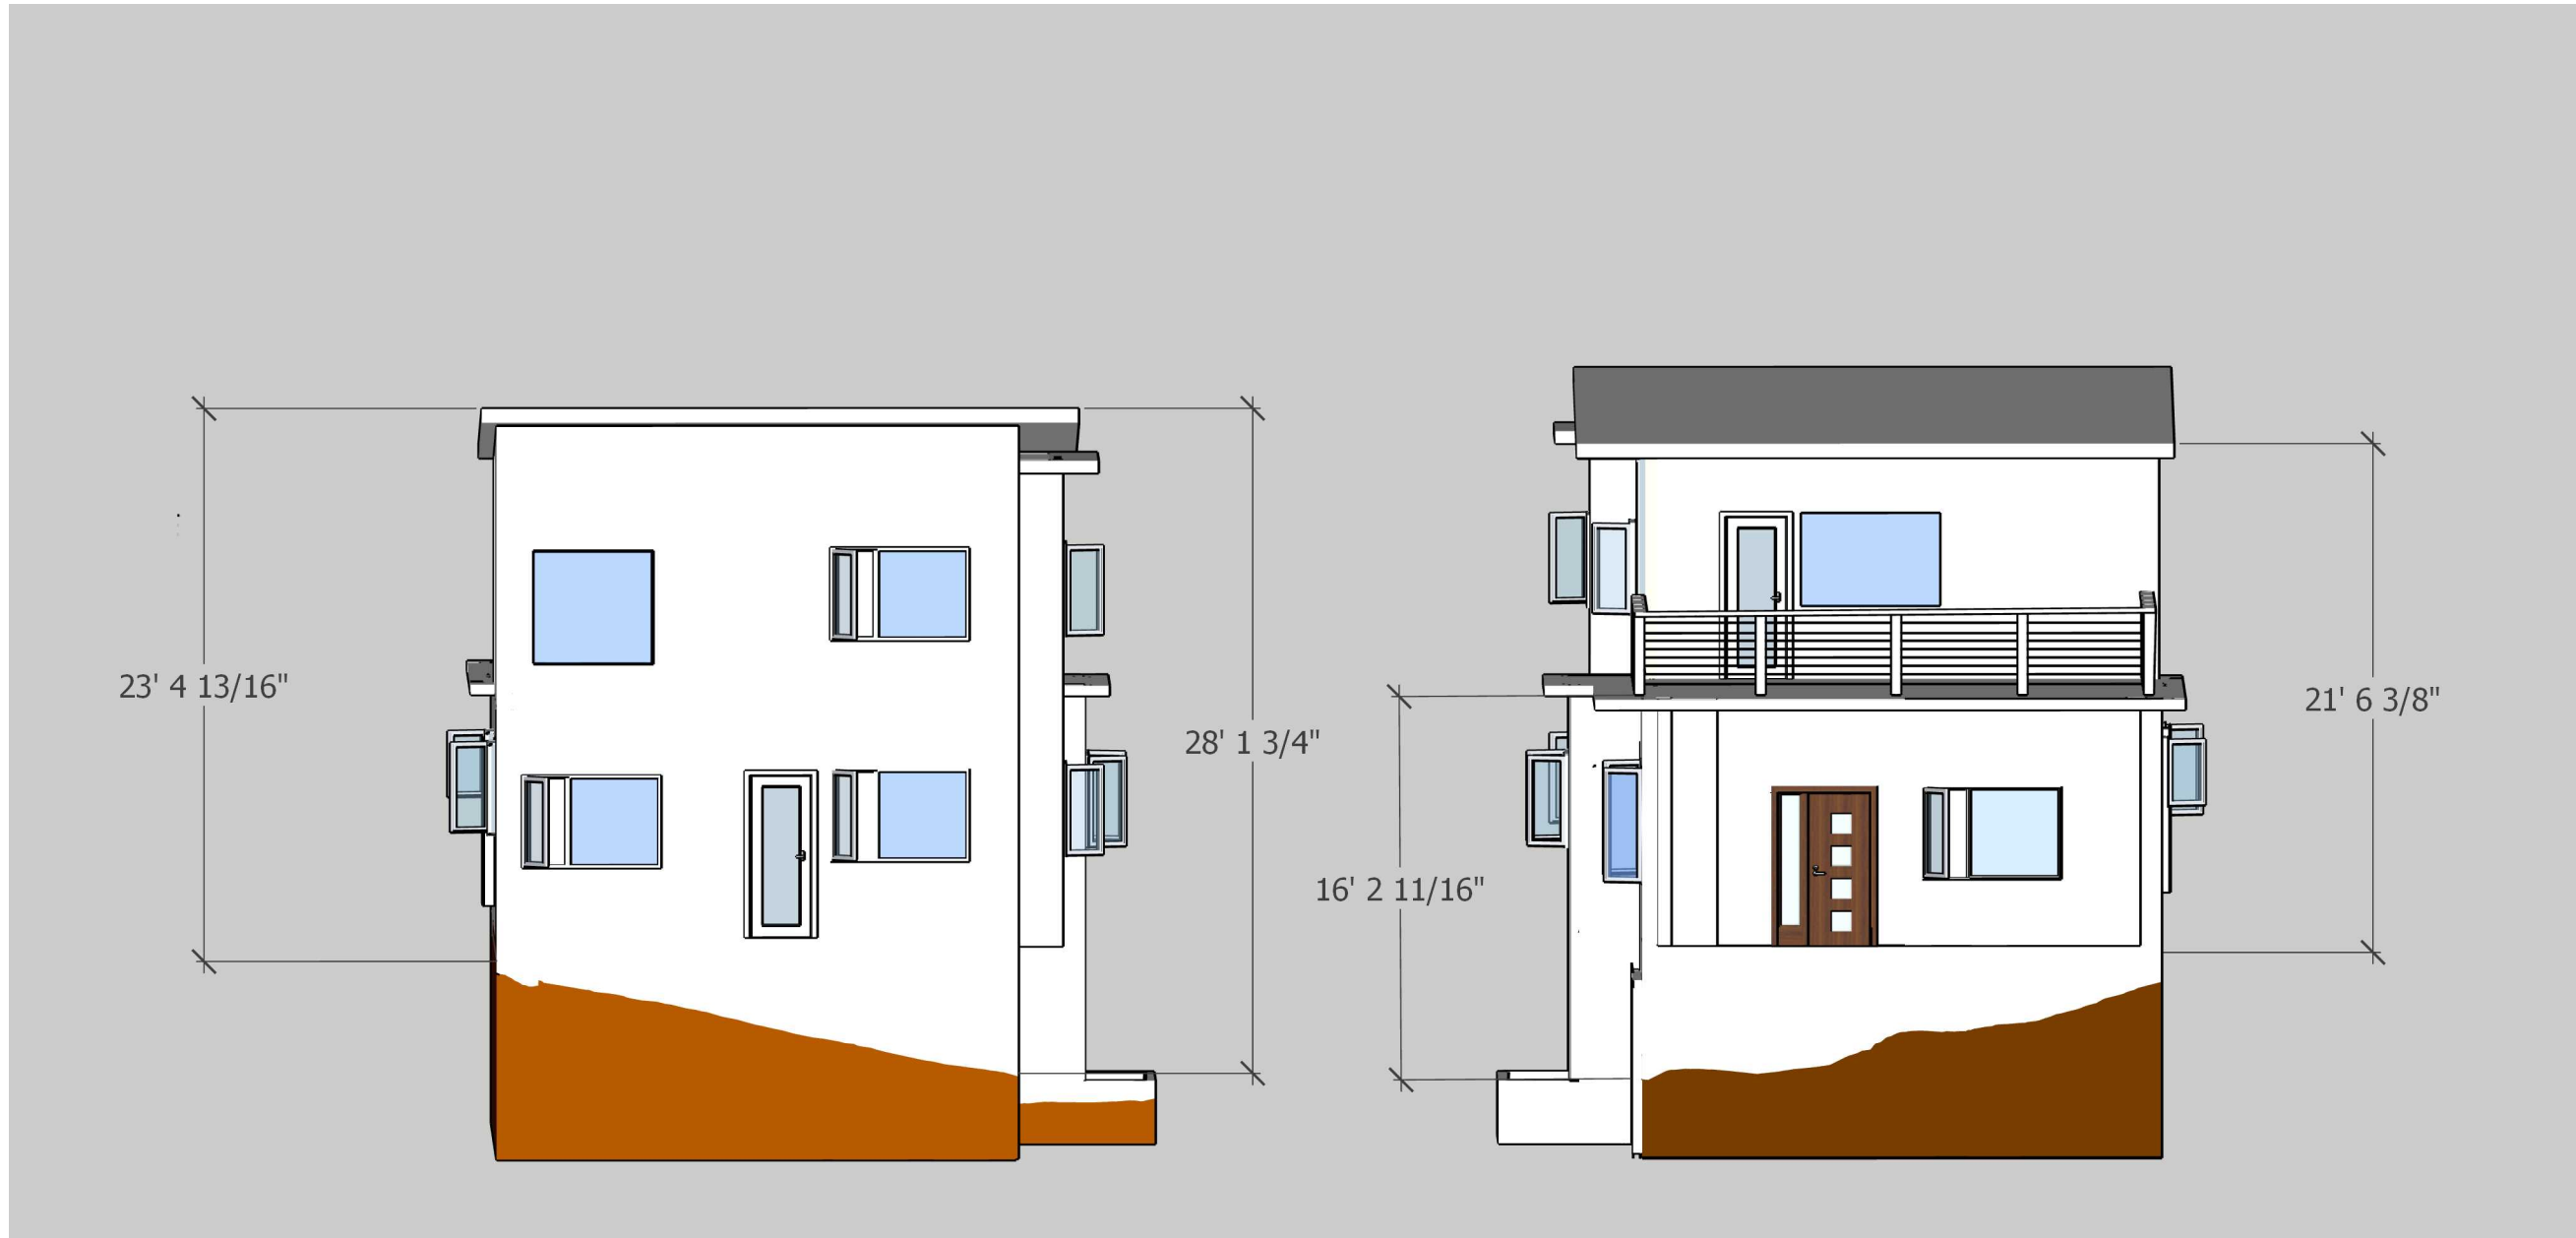

North

South

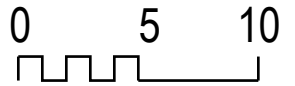

REVISIONS	
NO.	REMARKS
1	9/12/24
2	...
3	...
4	...
5	...

2758 Del Monte AV El Cerrito CA

**Proposed
N S ELEVATIONS**